

STATE ENGINEER  
Salem, Oregon

# Well Record

STATE WELL NO. 9/4W-3D  
COUNTY Polk  
APPLICATION NO. GR-1578

GR- 1520

*Polk*  
*3745*

OWNER: H. H. Withrow


MAILING ADDRESS: Rt. 1, Box 19

LOCATION OF WELL: Owner's No. #1

CITY AND STATE: Independence, Oregon

NW  $\frac{1}{4}$  NW  $\frac{1}{4}$  Sec. 3 T. 9 S., R. 4 W., W.M.

Bearing and distance from section or subdivision corner S. 87° 30' W. 4140' from NE cor. of Fielding M. Thorp DIC.

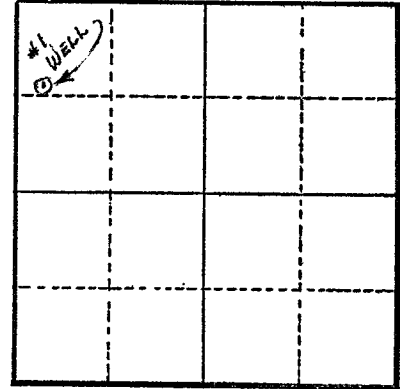

Altitude at well 160'

TYPE OF WELL: Drilled Date Constructed 1948

Depth drilled 35' Depth cased 35'

Section 3

### CASING RECORD:

10"

### FINISH:

Slot perforations about 2 1/2" apart

### AQUIFERS:

### WATER LEVEL:

16'

PUMPING EQUIPMENT: Type Gardner Denver 3" H.P. 30  
Capacity 500 G.P.M.

### WELL TESTS:

Drawdown 3 ft. after \_\_\_\_\_ hours 600 G.P.M.

Drawdown \_\_\_\_\_ ft. after \_\_\_\_\_ hours \_\_\_\_\_ G.P.M.

USE OF WATER Irrigation Temp. \_\_\_\_\_ °F. \_\_\_\_\_, 19

SOURCE OF INFORMATION GR Record

DRILLER or DIGGER Art Sloper

### ADDITIONAL DATA:

Log \_\_\_\_\_ Water Level Measurements \_\_\_\_\_ Chemical Analysis \_\_\_\_\_ Aquifer Test \_\_\_\_\_

### REMARKS:

Log: Top soil & clay 0 to 12 ft.  
Gravel 12 to 35 ft.

Irrigation of 51.1 acres.