

STATE ENGINEER
Salem, Oregon

Well Record

STATE WELL NO. 9/4W-3E
COUNTY Polk
APPLICATION NO. GR-1579

GR- 1521

OWNER: H. H. Withrow


MAILING ADDRESS: Rt. 1, Box 19

LOCATION OF WELL: Owner's No. #2

CITY AND STATE: Independence, Oregon

SW 1/4 NW 1/4 Sec. 3 T. 9 S., R. 4 W., W.M.

Bearing and distance from section or subdivision corner S.78°W. 2260' from NE cor. of Fielding M. Thorp DLC.

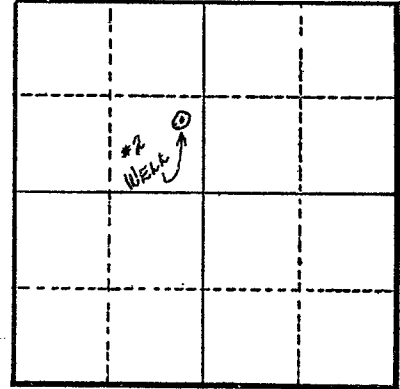

Section 3

Altitude at well 160'

TYPE OF WELL: Drilled Date Constructed 1952

Depth drilled 30' Depth cased 30'

CASING RECORD:
12"

FINISH:
Slot perforations about 2 1/2" apart.

AQUIFERS:

WATER LEVEL:
8'

PUMPING EQUIPMENT: Type Gardner Denver 3" H.P. 30
Capacity 500 G.P.M.

WELL TESTS:
Drawdown 3 ft. after 500 hours G.P.M.
Drawdown _____ ft. after _____ hours _____ G.P.M.

USE OF WATER Irrigation Temp. _____ °F., 19

SOURCE OF INFORMATION GR Record

DRILLER or DIGGER Bill Hamilton

ADDITIONAL DATA:

Log _____ Water Level Measurements _____ Chemical Analysis _____ Aquifer Test _____

REMARKS:

Log: Gravel 0 to 30 ft.

Irrigation of 29.5 acres.