


STATE ENGINEER
Salem, Oregon

Well Record *Polk* STATE WELL NO. 9/~~4W~~-3L
COUNTY *Polk*
GR- 1522 *3747* APPLICATION NO. GR- 1580

OWNER: *H. H. Withrow*
MAILING ADDRESS: *Rt. 1, Box 19*
CITY AND STATE: *Independence, Oregon*

LOCATION OF WELL: Owner's No. *#3*
NE 1/4 *SW* 1/4 Sec. *3* T. *9* S., R. *4* W., W.M.

Bearing and distance from section or subdivision
corner *S. 50°30' W. 3860' from NE cor. Fielding*
M. Thorp DLC.

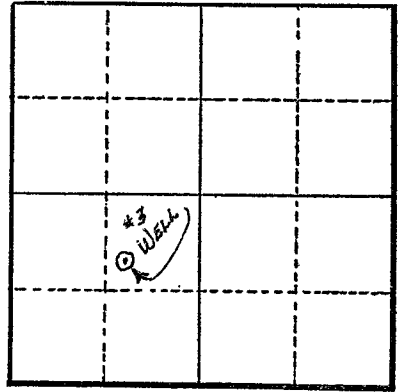

Altitude at well *160'*

TYPE OF WELL: *Drilled* Date Constructed *1952*

Depth drilled *51'* Depth cased *51'*

Section *3*

CASING RECORD:
12"

FINISH:
Slot perforations about 2 1/2" apart

AQUIFERS:

WATER LEVEL:
31'

PUMPING EQUIPMENT: Type *Turbine* H.P. *15*
Capacity *300* G.P.M.

WELL TESTS:
Drawdown *5* ft. after *300* hours G.P.M.
Drawdown _____ ft. after _____ hours G.P.M.

USE OF WATER *Irrigation* Temp. _____ °F. _____, 19

SOURCE OF INFORMATION *GR Record*

DRILLER or DIGGER *Art Clinton*

ADDITIONAL DATA:
Log _____ Water Level Measurements _____ Chemical Analysis _____ Aquifer Test _____

REMARKS:
Log: Top soil 0 to 3 ft.
Clay 3 to 23 ft.
Gravel 23 to 51 ft.

Irrigation of 68.6 acres.