

STATE ENGINEER
Salem, Oregon

Well Record

STATE WELL NO. 9/4W-4F(1)
COUNTY Polk
APPLICATION NO. GR-1052

GR- 1014

Polk
3751

OWNER: George Stapleton


MAILING
ADDRESS:

LOCATION OF WELL: Owner's No. #1

CITY AND
STATE: Independence, Oregon

SE 1/4 NW 1/4 Sec. 4 T. 9 S., R. 4 W., W.M.

Bearing and distance from section or subdivision
corner 2000' S. & 1420' E. from NW cor. Sec. 4.

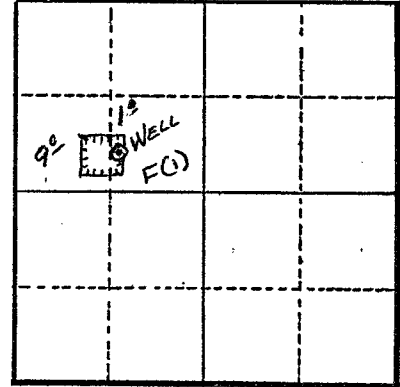

Section 4

Altitude at well 180 ft.

TYPE OF WELL: Drilled Date Constructed 1944

Depth drilled 42 ft. Depth cased 41 ft.

CASING RECORD:

12 inch

FINISH:

Perforated- torch cut slots from 31 to 41 ft.

AQUIFERS:

WATER LEVEL:

24 ft.

PUMPING EQUIPMENT: Type 4" Cent. H.P. 7

Capacity 275 G.P.M.

WELL TESTS:

Drawdown ft. after hours G.P.M.

Drawdown ft. after hours G.P.M.

USE OF WATER Irrigation Temp. °F. 19

SOURCE OF INFORMATION G.R. Record

DRILLER or DIGGER Art. Sloper

ADDITIONAL DATA:

Log Water Level Measurements Chemical Analysis Aquifer Test

REMARKS:

Log: Top soil 0 to 6 ft.
Blue Clay 6 to 29 ft.
Gravel 29 to 41 ft.

Irrigation of 10 acres.