

STATE ENGINEER
Salem, Oregon

OBSERVATION WELL

Well Record

STATE WELL NO. 9/LW-8N(1)
COUNTY Polk
APPLICATION NO. GR- 576

OWNER: Max D. Mayfield (D.W. CHRISTIANSON)


MAILING ADDRESS: Rt. 1 Box 170

LOCATION OF WELL: Owner's No.

CITY AND STATE: Independence, Oregon

SW 1/4 SW 1/4 Sec. 8 T. 9 S., R. 4 W., W.M.

Bearing and distance from section or subdivision
corner 200' N. & 500' E. from SW cor. of sec. 8

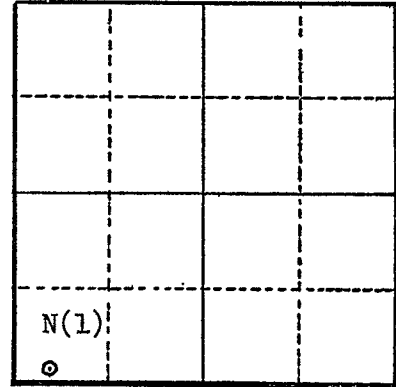

Section 8

Altitude at well 260'

TYPE OF WELL: Drilled Date Constructed 1948

Depth drilled 120' Depth cased 120'

CASING RECORD:

6 inch

FINISH:

AQUIFERS:

WATER LEVEL:

10 feet

PUMPING EQUIPMENT: Type Jet H.P. 3
Capacity 50 G.P.M.

WELL TESTS:

Drawdown 40 ft. after 50 hours G.P.M.

Drawdown ft. after hours G.P.M.

USE OF WATER Irrigation (15 acres) Temp. °F., 19

SOURCE OF INFORMATION GR- 549

DRILLER or DIGGER

ADDITIONAL DATA:

Log NA Water Level Measurements Chemical Analysis Aquifer Test

REMARKS: