

STATE ENGINEER  
Salem, Oregon

# Well Record

*Polk*  
*3804*

STATE WELL NO. 9/LW-10K(1)  
COUNTY Polk  
APPLICATION NO. GR- 65

OWNER: Robert J. Fitts


MAILING  
ADDRESS: \_\_\_\_\_

LOCATION OF WELL: Owner's No. 1

CITY AND  
STATE: Independence, Oregon

SE  $\frac{1}{4}$  NE  $\frac{1}{4}$  Sec. 10 T. 9 <sup>XX</sup> S., R. 4 <sup>XX</sup> W., W.M.

Bearing and distance from section or subdivision  
corner 2000' SW of NW cor. of John Thorp DLC.

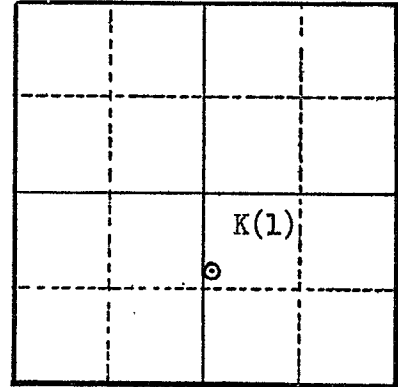

Section 10

Altitude at well 160'

TYPE OF WELL: Drilled Date Constructed 1952

Depth drilled 35' Depth cased 35'

CASING RECORD:  
12 inch

FINISH:

AQUIFERS:

WATER LEVEL:  
15 feet

PUMPING EQUIPMENT: Type \_\_\_\_\_ H.P. \_\_\_\_\_  
Capacity \_\_\_\_\_ G.P.M.

WELL TESTS:  
Drawdown Not tested ft. after \_\_\_\_\_ hours \_\_\_\_\_ G.P.M.  
Drawdown \_\_\_\_\_ ft. after \_\_\_\_\_ hours \_\_\_\_\_ G.P.M.

USE OF WATER Irrigation (85 acres) Temp. \_\_\_\_\_ °F. \_\_\_\_\_, 19\_\_\_\_

SOURCE OF INFORMATION GR- 56

DRILLER or DIGGER \_\_\_\_\_

ADDITIONAL DATA:

Log NA Water Level Measurements \_\_\_\_\_ Chemical Analysis \_\_\_\_\_ Aquifer Test \_\_\_\_\_

REMARKS:

Water to be applied before July 1958