

STATE ENGINEER
Salem, Oregon

Well Record

Polk STATE WELL NO. 9/LW-11A(1)
3814 COUNTY Polk
APPLICATION NO. GR-311

OWNER: Earl Stonebrook


MAILING ADDRESS: Rt. 1 Box 40

LOCATION OF WELL: Owner's No. 3

CITY AND STATE: Independence, Oregon

SE $\frac{1}{4}$ NE $\frac{1}{4}$ Sec. 11 T. 9 ^{XN} S., R. 4 ^{XE} W., W.M.

Bearing and distance from section or subdivision corner 1320' N. & 100' W. from E $\frac{1}{4}$ cor. of sec. 11

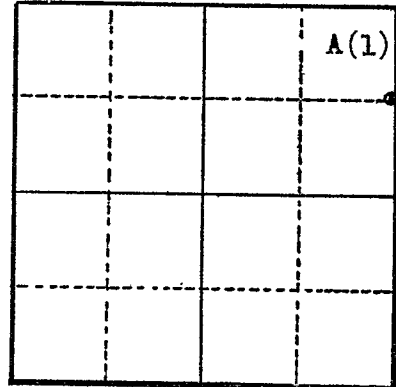

Section 11

Altitude at well 165'

TYPE OF WELL: Drilled Date Constructed 1920

Depth drilled 30' Depth cased 30'

CASING RECORD:

12 inch

FINISH:

Perforated from 22 to 30 feet

AQUIFERS:

Silt & sand from 0 to 30 feet

WATER LEVEL:

15 feet

PUMPING EQUIPMENT: Type F. M. centrifugal

H.P. 40

Capacity 1000 G.P.M.

WELL TESTS:

Drawdown 4 ft. after 1000 hours 1000 G.P.M.

Drawdown _____ ft. after _____ hours _____ G.P.M.

USE OF WATER Irrigation (40 acres) Temp. _____ °F. _____, 19____

SOURCE OF INFORMATION GR- 293

DRILLER or DIGGER Sloper

ADDITIONAL DATA:

Log NA Water Level Measurements _____ Chemical Analysis _____ Aquifer Test _____

REMARKS: