

STATE ENGINEER
Salem, Oregon

Well Record *Polk 3815* STATE WELL NO. 9/LW-11B(1)
COUNTY Polk
APPLICATION NO. GR- 65

OWNER: Robert J. Fitts


MAILING ADDRESS: _____

LOCATION OF WELL: Owner's No. 3

CITY AND STATE: Independence, Oregon

NW $\frac{1}{4}$ NE $\frac{1}{4}$ Sec. 11 T. 9 ^{XN.} S., R. 4 ^{XX} W., W.M.

Bearing and distance from section or subdivision corner 1000' S. & 2150' W. from NE cor. of sec. 11

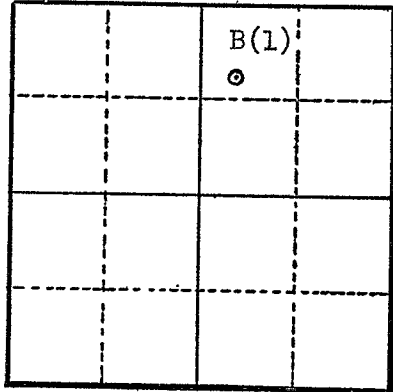

Altitude at well 150'

TYPE OF WELL: Drilled Date Constructed Prior 1935

Depth drilled 30' Depth cased 30'

Section 11

CASING RECORD:
10 inch

FINISH: _____

AQUIFERS: _____

WATER LEVEL:
17 feet

PUMPING EQUIPMENT: Type F. M. H.P. 45
Capacity 900 G.P.M.

WELL TESTS:
Drawdown _____ ft. after _____ hours _____ G.P.M.
Drawdown _____ ft. after _____ hours _____ G.P.M.

USE OF WATER Irrigation (105.2 acres) Temp. _____ °F. _____, 19____

SOURCE OF INFORMATION GR- 56

DRILLER or DIGGER _____

ADDITIONAL DATA:
Log NA Water Level Measurements _____ Chemical Analysis _____ Aquifer Test _____

REMARKS: _____