

STATE ENGINEER
Salem, Oregon

Well Record

STATE WELL NO. 9/W-11D(1)
COUNTY Polk
APPLICATION NO. GR-65

OWNER: Robert J. Fitts

MAILING ADDRESS:


LOCATION OF WELL: Owner's No. 2

CITY AND STATE:

Independence, Oregon

NW 1/4 NW 1/4 Sec. 11 T. 9 S., R. 4 W., W.M.

Bearing and distance from section or subdivision corner N. side of county rd. & 100' E. of NW cor. of the John Thorp DLC.

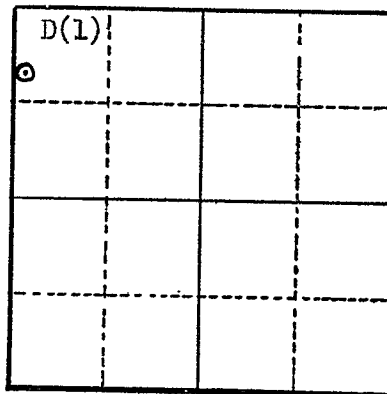

Section 11

Altitude at well 160'

TYPE OF WELL: Drilled Date Constructed 1952

Depth drilled 35' Depth cased 35'

CASING RECORD:
12 inch

FINISH:

AQUIFERS:

WATER LEVEL:
15 feet

PUMPING EQUIPMENT: Type Electric? H.P. ?
Capacity 500 G.P.M.

WELL TESTS:
Drawdown No test ft. after _____ hours _____ G.P.M.
Drawdown _____ ft. after _____ hours _____ G.P.M.

USE OF WATER Irrigation (60 acres) Temp. _____ °F. _____, 19____

SOURCE OF INFORMATION GR-56

DRILLER or DIGGER _____

ADDITIONAL DATA:
Log NA Water Level Measurements _____ Chemical Analysis _____ Aquifer Test _____

REMARKS: