

Well Record

Polk STATE WELL NO. 9/W-11H(1)
3809 COUNTY Polk
APPLICATION NO. GR-311

OWNER: Earl Stonebrook


MAILING ADDRESS: Rt. 1 Box 40

LOCATION OF WELL: Owner's No. 4

CITY AND STATE: Independence, Oregon

SE $\frac{1}{4}$ NE $\frac{1}{4}$ Sec. 11 T. 9 ^{XXX} S., R. 4 ^{XX} W., W.M.

Bearing and distance from section or subdivision corner 1320' N. & 1300' W. from E $\frac{1}{4}$ cor. of sec. 11

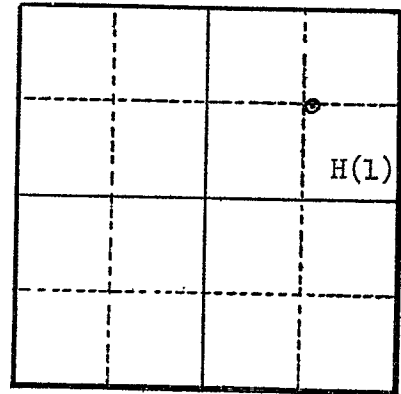

Section 11

Altitude at well 165'

TYPE OF WELL: Drilled Date Constructed 1950

Depth drilled 30' Depth cased 30'

CASING RECORD:
12 inch

FINISH:

AQUIFERS:

Gravel from 12 to 30'

WATER LEVEL:

15 feet

PUMPING EQUIPMENT: Type 2"x3" H.P. 20
Capacity 400 G.P.M.

WELL TESTS:

Drawdown 4 ft. after _____ hours 1000 G.P.M.

Drawdown _____ ft. after _____ hours _____ G.P.M.

USE OF WATER Irrigation (80 acres) Temp. _____ °F., 19____

SOURCE OF INFORMATION GR-293

DRILLER or DIGGER _____

ADDITIONAL DATA:

Log X Water Level Measurements _____ Chemical Analysis _____ Aquifer Test _____

REMARKS:

Silt 0 to 12
Gravel 12 to 30