

STATE ENGINEER
Salem, Oregon

Well Record

STATE WELL NO. 9/4W-11J(1)
COUNTY Polk
APPLICATION NO. GR-1236

GR- 1195

Polk
3829

OWNER: Roy Wooldridge


MAILING ADDRESS:

LOCATION OF WELL: Owner's No. #1

CITY AND STATE: Independence, Oregon

NE ¼ SE ¼ Sec. 11 T. 9 S., R. 4 W., W.M.

Bearing and distance from section or subdivision corner S47°20'W. 1314.5' from E¼ of Sec. 11.

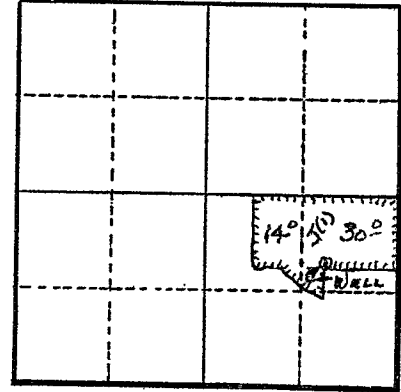

Section 11

Altitude at well 165 ft.

TYPE OF WELL: Drilled Date Constructed 1946

Depth drilled 36 ft. Depth cased 36 ft.

CASING RECORD:

12 in.

FINISH:

AQUIFERS:

WATER LEVEL:

16 ft.

PUMPING EQUIPMENT: Type Cornell 4 in. Cent.

H.P. 20

Capacity 500 G.P.M.

WELL TESTS:

Drawdown _____ ft. after _____ hours _____ G.P.M.

Drawdown _____ ft. after _____ hours _____ G.P.M.

USE OF WATER Irrigation Temp. _____ °F. _____, 19

SOURCE OF INFORMATION G.R. Record

DRILLER or DIGGER Art Clinton

ADDITIONAL DATA:

Log _____ Water Level Measurements _____ Chemical Analysis _____ Aquifer Test _____

REMARKS:

Log: Top soil 0 to 5 ft.
Clay 5 to 9 ft.
Sand & gravel 9 to 36 ft.

Irrigation of 44 acres.