

STATE ENGINEER
Salem, Oregon

Well Record

STATE WELL NO. 9/LW-11K(1)
COUNTY Polk
APPLICATION NO. GR-342

OWNER: Ovid G. Long


MAILING ADDRESS: Box 302

LOCATION OF WELL: Owner's No. 1

CITY AND STATE: Independence, Oregon

NW 1/4 SE 1/4 Sec. 11 T. 9 S., R. 4 W., W.M.

Bearing and distance from section or subdivision corner 11.02 ch. E. & 26 ch. S. from NE cor. of DLC. #57.

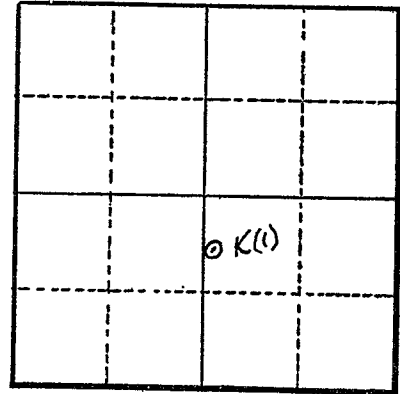

Section 11

Altitude at well 165'

TYPE OF WELL: Drilled Date Constructed Mar. 1948

Depth drilled 33' Depth cased _____

CASING RECORD:
12 inch

FINISH:

AQUIFERS:

WATER LEVEL:
14 feet

PUMPING EQUIPMENT: Type F. M. 3"xl" H.P. 25
Capacity 500 G.P.M.

WELL TESTS:
Drawdown _____ ft. after _____ hours 620 G.P.M.
Drawdown _____ ft. after _____ hours _____ G.P.M.

USE OF WATER Irrigation (48 acres) Temp. _____ °F. _____, 19____

SOURCE OF INFORMATION GR-327

DRILLER or DIGGER E. Hamilton, Albany

ADDITIONAL DATA:

Log NA Water Level Measurements _____ Chemical Analysis _____ Aquifer Test _____

REMARKS: