

STATE ENGINEER
Salem, Oregon

Well Record

STATE WELL NO. 9/LW-111
COUNTY Benton Polk
APPLICATION NO. GR-3127

OWNER: McLaughlin, Robert L.
(Vera E. Coleman (trustee))


MAILING ADDRESS: P.O. Box 250

LOCATION OF WELL: Owner's No.

CITY AND STATE: Corvallis, Oregon

NE 1/4 SW 1/4 Sec. 11 T. 9 S., R. 4 W., W.M.

Bearing and distance from section or subdivision
corner S. 12° E 1430' from NE Cor. Jno. Thorp.
DLC

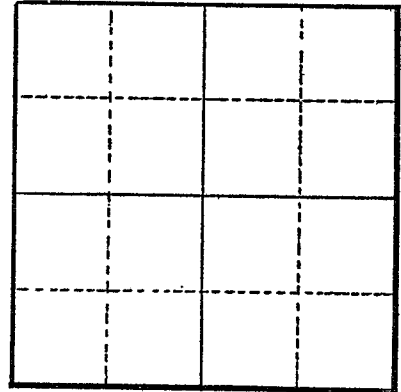

Section

Altitude at well

TYPE OF WELL: Drilled Date Constructed 1946

Depth drilled 47' Depth cased 47'

CASING RECORD:
12"

FINISH:

Cut with Torch from 37 to 47

AQUIFERS:

Sandy Loam
Gravel

WATER LEVEL:

15'

PUMPING EQUIPMENT: Type Centrifugal 3x4 A.C.

H.P. 60

Capacity G.P.M.

WELL TESTS:

Drawdown 5 ft. after hours pumping 1065 G.P.M.

Drawdown ft. after hours G.P.M.

USE OF WATER Irrigation

Temp. °F., 19

SOURCE OF INFORMATION GR-2934

DRILLER or DIGGER

ADDITIONAL DATA:

Log X Water Level Measurements Chemical Analysis Aquifer Test

REMARKS:

Sandy Loam 0 44
Gravel 44 47