

STATE ENGINEER
Salem, Oregon

Well Record

STATE WELL NO. 9/4W-111
COUNTY Polk
APPLICATION NO. GR-1434


GR- 1388

OWNER: Grenold Collins (Porterfield Farm) MAILING ADDRESS: Rt. 1, Box 38

LOCATION OF WELL: Owner's No. _____ CITY AND STATE: Independence, Oregon

NE 1/4 SW 1/4 Sec. 11 T. 9 S., R. 4 W., W.M.

Bearing and distance from section or subdivision
corner 1380' S. 19°30' W. from NE cor. Thorp DIC

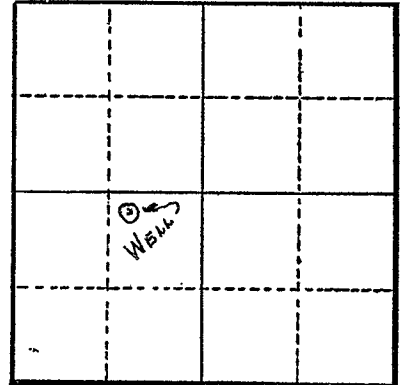

Section 11

Altitude at well 105'

TYPE OF WELL: Drilled Date Constructed 1942

Depth drilled 46' Depth cased 46'

CASING RECORD:

10" from 8' to 46'

FINISH:

Perforated from 38' to 46'

AQUIFERS:

WATER LEVEL:

6' to 12'

PUMPING EQUIPMENT: Type Portable H.P. _____
Capacity _____ G.P.M.

WELL TESTS:

Drawdown 6 ft. after _____ hours 450 G.P.M.

Drawdown _____ ft. after _____ hours _____ G.P.M.

USE OF WATER Irrigation Temp. _____ °F. _____, 19____

SOURCE OF INFORMATION GR Record

DRILLER or DIGGER Art Sloper

ADDITIONAL DATA:

Log N.A. Water Level Measurements _____ Chemical Analysis _____ Aquifer Test _____

REMARKS:

Irrigation of 37.1 acres.