

OWNER: Gail Prather


MAILING ADDRESS: Route 1

LOCATION OF WELL: Owner's No. _____

CITY AND STATE: Independence, Oregon

SW SE 11 9 N. 4 E.
_____ ¼ _____ ¼ Sec. _____ T. _____ S., R. _____ W., W.M.

Bearing and distance from section or subdivision
corner 39.185 chains N. 83° 35' W.

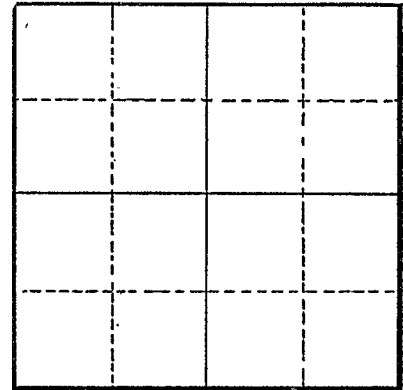

Section _____

Altitude at well _____

TYPE OF WELL: Dug Date Constructed 1946

Depth drilled 34 Depth cased 31

CASING RECORD:

10-inch

FINISH:

Perforations from 23 to 31

AQUIFERS:

Sand and gravel

WATER LEVEL:

12-feet

PUMPING EQUIPMENT: Type Allis Chalmers Centrifugal H.P. 25
Capacity 500 G.P.M.

WELL TESTS:

Drawdown 1½ ft. after _____ hours Pumping 500 G.P.M.
Drawdown _____ ft. after _____ hours _____ G.P.M.

USE OF WATER Irrigation Temp. _____ °F. _____, 19_____

SOURCE OF INFORMATION GR-1986

DRILLER or DIGGER Bill Hamilton 3rd. Ave. Albany, Oregon

ADDITIONAL DATA:

Log Water Level Measurements _____ Chemical Analysis _____ Aquifer Test _____

REMARKS:

Sand 0 19
Gravel 19 34