

STATE ENGINEER
Salem, Oregon

Well Record

STATE WELL NO. 9/LW-11R(1)
COUNTY Polk
APPLICATION NO. GR- 106

OWNER: Robert J. Cobine


MAILING ADDRESS: _____

LOCATION OF WELL: Owner's No. 1

CITY AND STATE: Independence, Oregon

SE 1/4 SE 1/4 Sec. 11 T. 9 S., R. 4 W., W.M.

Bearing and distance from section or subdivision
corner 1430' N.55°W. from SE cor. of sec. 11

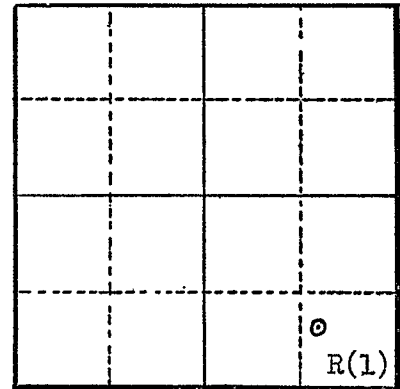

Section 11

Altitude at well 140'

TYPE OF WELL: Drilled Date Constructed 7/8/50

Depth drilled 25' Depth cased 25'

CASING RECORD:
10 inch

FINISH:
30 perforations (1/2"x6") set from 19 to 25 feet

AQUIFERS:
Gravel from 10 to 25 feet

WATER LEVEL:
4 to 8 feet

PUMPING EQUIPMENT: Type F. M. - Ford H.P. 110 gas
Capacity * G.P.M.

WELL TESTS:
Drawdown 0 ? ft. after _____ hours 600 G.P.M.
Drawdown _____ ft. after _____ hours _____ G.P.M.

USE OF WATER Irrigation (48 acres) Temp. _____ °F. _____, 19____

SOURCE OF INFORMATION GR- 98

DRILLER or DIGGER Art Clinton, Independence

ADDITIONAL DATA:
Log X Water Level Measurements _____ Chemical Analysis _____ Aquifer Test _____

REMARKS:
Loam, clay 0 to 3
Loam, heavy clay 3 to 10
Gravel 10 to 25