

STATE ENGINEER
Salem, Oregon

Well Record

STATE WELL NO. 9/LW-11R(2)
COUNTY Polk
APPLICATION NO. GR- 106

OWNER: Robert J. Cobine


MAILING ADDRESS: _____

LOCATION OF WELL: Owner's No. 2

CITY AND STATE: Independence, Oregon

SE $\frac{1}{4}$ SE $\frac{1}{4}$ Sec. 11 T. 9 S., R. 4 W., W.M.

Bearing and distance from section or subdivision corner 1060' N.30°W. from SE Cor. of Sec. 11

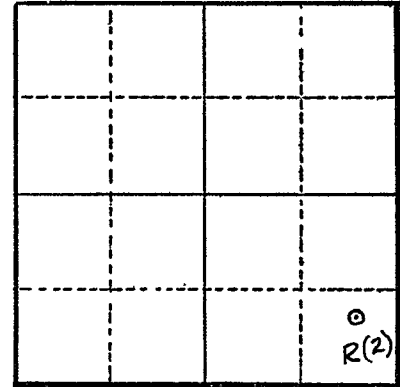

Section 11

Altitude at well 140'

TYPE OF WELL: Drilled Date Constructed 7/8/50

Depth drilled 32' Depth cased 32'

CASING RECORD:

10 inch

FINISH:

30 perforations ($\frac{1}{2}$ "x6") set from 26 to 32 feet

AQUIFERS:

Gravel from 18 to 32 feet

WATER LEVEL:

17 feet (1950)

PUMPING EQUIPMENT: Type Irrigation (48 acres) F. M. 4"x5" Ford H.P. 110 gas

Capacity 600? G.P.M.

WELL TESTS:

Drawdown 0 ? ft. after _____ hours 600 G.P.M.

Drawdown _____ ft. after _____ hours _____ G.P.M.

USE OF WATER Irrigation (48 acres) Temp. _____ °F. _____, 19____

SOURCE OF INFORMATION GR- 98

DRILLER or DIGGER Art Clinton, Independence

ADDITIONAL DATA:

Log X Water Level Measurements _____ Chemical Analysis _____ Aquifer Test _____

REMARKS:

Loam, clay silt 0 to 3
Clay, silty 3 to 18
Gravel 18 to 32