

STATE ENGINEER  
Salem, Oregon

# Well Record


*Polk*  
*38391*  
STATE WELL NO. 9/4W-12A  
COUNTY POLK  
APPLICATION NO. GR-2435

OWNER: Mildred Hill DBA Werline Hop Ranch MAILING ADDRESS: Rt. 1, Box 46,

LOCATION OF WELL: Owner's No. #2 CITY AND STATE: Independence, Oregon

NE  $\frac{1}{4}$  NE  $\frac{1}{4}$  Sec. 12 T. 9 N S, R. 4 E W., W.M.

Bearing and distance from section or subdivision corner 1000' S. and 700' W.

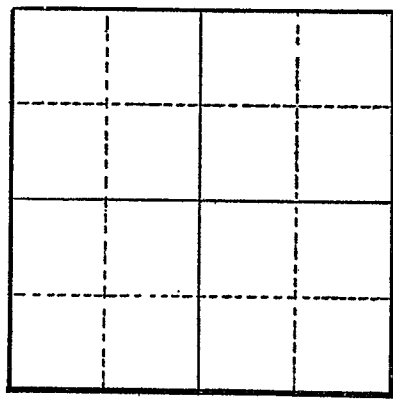

Section .....

Altitude at well .....

TYPE OF WELL: Drilled Date Constructed 1949

Depth drilled 35 Depth cased 35

CASING RECORD:

10-inch

FINISH:

AQUIFERS:

soil, sand and gravel

WATER LEVEL:

16-feet

PUMPING EQUIPMENT: Type Rain o flow H.P. 40  
Capacity 800 G.P.M.

WELL TESTS:

Drawdown 2 ft. after ..... hours Pumping 800 G.P.M.  
Drawdown ..... ft. after ..... hours ..... G.P.M.

USE OF WATER Irrigation Temp. .... °F. ...., 19

SOURCE OF INFORMATION GR-2310

DRILLER or DIGGER .....

ADDITIONAL DATA:

Log X Water Level Measurements ..... Chemical Analysis ..... Aquifer Test .....

REMARKS:

- 0" - 12" heavy soil
- 12" - 22" sand & gravel
- 22" - 35" water bearing gravel