

STATE ENGINEER  
Salem, Oregon


Well Record *Polk* STATE WELL NO. *9/4W-12B*  
*3840* COUNTY *Polk*  
GR- 1371 APPLICATION NO. *GR- 1417*

OWNER: *Gerald Morlan* MAILING ADDRESS: *Rt. 1, Box 45*

LOCATION OF WELL: Owner's No. *#1* CITY AND STATE: *Independence, Oregon*

*NW* 1/4 *NE* 1/4 Sec. *12* T. *9* S., R. *4* W., W.M.

Bearing and distance from section or subdivision corner *1450' S. 26°30' E. from NE cor. of John Lewis DIC.*

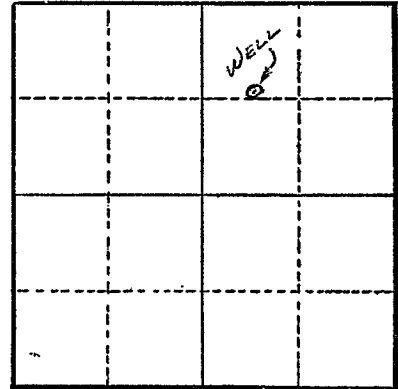

Section *12*

Altitude at well *275'*

TYPE OF WELL: *Drilled* Date Constructed *1930*

Depth drilled *35'* Depth cased *35'*

CASING RECORD:  
*12"*

FINISH:

AQUIFERS:

WATER LEVEL:  
*15'*

PUMPING EQUIPMENT: Type *F. M. Cent.* H.P. *40*  
Capacity *1000* G.P.M.

WELL TESTS:  
Drawdown *2* ft. after *900* hours G.P.M.  
Drawdown \_\_\_\_\_ ft. after \_\_\_\_\_ hours G.P.M.

USE OF WATER *Irrigation* Temp. \_\_\_\_\_ °F., 19

SOURCE OF INFORMATION *G. R. Record*

DRILLER or DIGGER *Sloper Bros.*

ADDITIONAL DATA:  
Log \_\_\_\_\_ Water Level Measurements \_\_\_\_\_ Chemical Analysis \_\_\_\_\_ Aquifer Test \_\_\_\_\_

REMARKS:

Log: *Silt* 0 to 15 ft.  
*Gravel* 15 to 35 ft.

*Irrigation of 80.1 acres.*