

STATE ENGINEER
Salem, Oregon

Well Record

POLK
3812

STATE WELL NO. 9/4W-12K
COUNTY POLK
APPLICATION NO. GR-2902

OWNER: Warren or Vern McGowan


MAILING ADDRESS: Pilot Rock, Oregon

LOCATION OF WELL: Owner's No. #1

CITY AND STATE:

NW 1/4 SE 1/4 Sec. 12 T. 9 N. 4 S, R. 4 E. W., W.M.

Bearing and distance from section or subdivision corner S. 78° 30' W. 1640'

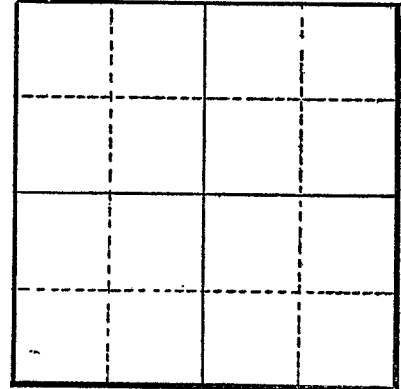

Section

Altitude at well

TYPE OF WELL: Drilled Date Constructed 1945

Depth drilled 34 Depth cased

CASING RECORD:

10-inch

FINISH:

AQUIFERS:

WATER LEVEL:
17-feet

PUMPING EQUIPMENT: Type Fairbanks Morse Centrifugal H.P. 10
Capacity 315 G.P.M.

WELL TESTS:

Drawdown 1.5 ft. after hours Pumping used 312 G.P.M.
Drawdown ft. after hours G.P.M.

USE OF WATER Irrigation Temp. °F., 19.....

SOURCE OF INFORMATION GR-2731

DRILLER or DIGGER Art Clinton

ADDITIONAL DATA:

Log Water Level Measurements Chemical Analysis Aquifer Test

REMARKS: