

STATE ENGINEER
Salem, Oregon

Well Record

Polk
3845

STATE WELL NO. 9/WW-12P(1)
COUNTY Polk
APPLICATION NO. GR-1235

GR- 1194

OWNER: Ruth Miller

MAILING

ADDRESS: Rt. 1, Box 61


LOCATION OF WELL: Owner's No. #1

CITY AND

STATE: Independence, Oregon

SE 1/4 SW 1/4 Sec. 12 T. 9 S., R. 4 W., W.M.

Bearing and distance from section or subdivision
corner N73°28'E. 2019.5' from SW cor. Sec. 12.

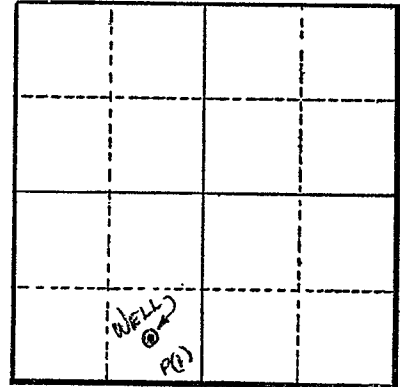

Section 12

Altitude at well 165 ft.

TYPE OF WELL: Drilled Date Constructed 1951

Depth drilled 36 ft. Depth cased 36 ft.

CASING RECORD:

10 inch

FINISH:

AQUIFERS:

WATER LEVEL:

14 ft.

PUMPING EQUIPMENT: Type Cornell 4 in. Cent. H.P. 30
Capacity 640 G.P.M.

WELL TESTS:

Drawdown 3 ft. after 600 hours G.P.M.

Drawdown ft. after hours G.P.M.

USE OF WATER Irrigation Temp. °F. 19

SOURCE OF INFORMATION G. R. Record

DRILLER or DIGGER Bill Hamilton

ADDITIONAL DATA:

Log Water Level Measurements Chemical Analysis Aquifer Test

REMARKS:

Log: Sand 0 to 15 ft.
Gravel & sand 15 to 36 ft.

Irrigation of 65 acres.