

STATE ENGINEER
Salem, Oregon

Well Record

Polk
3846


STATE WELL NO. 9/LW-12F(1)
COUNTY Polk
APPLICATION NO. GR- 311

OWNER: Earl Stonebrook MAILING ADDRESS: Rt. 1 Box 40

LOCATION OF WELL: Owner's No. 1 CITY AND STATE: Independence, Oregon

SE $\frac{1}{4}$ NW $\frac{1}{4}$ Sec. 12 T. 9 S., R. 4 W., W.M.

Bearing and distance from section or subdivision corner 1200' N. & 675' W. of Center of sec. 12

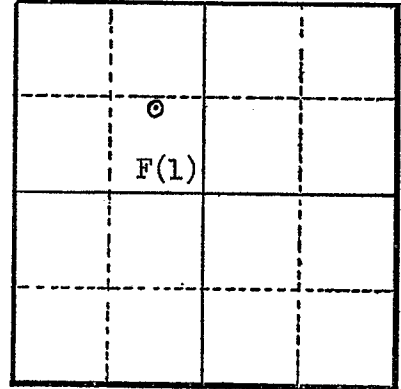

Section 12

Altitude at well 165'

TYPE OF WELL: Drilled Date Constructed 1920

Depth drilled 30 Depth cased _____

CASING RECORD:
12 inch

FINISH:
Perforated from 22 to 30 feet

AQUIFERS:
Gravels from 6 to 30 feet

WATER LEVEL:
10 feet

PUMPING EQUIPMENT: Type F. M. centrifugal 6"xl" H.P. 30
Capacity 1000 G.P.M.

WELL TESTS:
Drawdown 3 ft. after _____ hours 1000 G.P.M.
Drawdown _____ ft. after _____ hours _____ G.P.M.

USE OF WATER Irrigation (23 acres) Temp. _____ °F. _____, 19____

SOURCE OF INFORMATION GR- 293

DRILLER or DIGGER Sloper

ADDITIONAL DATA:
Log Water Level Measurements _____ Chemical Analysis _____ Aquifer Test _____

REMARKS:
Silt loam 0 to 6
Gravel 6 to 24