

STATE ENGINEER
Salem, Oregon

Well Record

Polk
3847

STATE WELL NO. 9/LW-12F(2)
COUNTY Polk
APPLICATION NO. GR- 311

OWNER: Earl Stonebrook


MAILING ADDRESS: Rt. 1 Box 40

LOCATION OF WELL: Owner's No. 2

CITY AND STATE: Independence, Oregon

SE $\frac{1}{4}$ NW $\frac{1}{4}$ Sec. 12 T. 9 ^{XXX} S., R. 4 ^{XXX} W., W.M.

Bearing and distance from section or subdivision corner 900' N. & 1400' E from W $\frac{1}{4}$ cor. of sec. 12

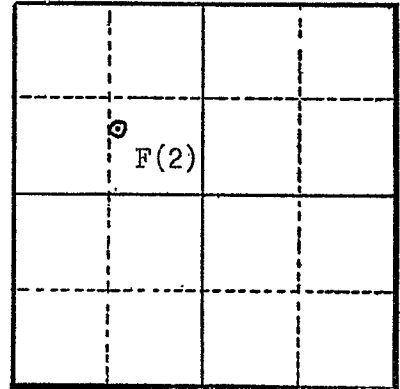

Altitude at well 165'

TYPE OF WELL: Drilled Date Constructed 1920

Depth drilled 30' Depth cased 30'

Section 12

CASING RECORD:
12 inch

FINISH:
Perforations set from 22 to 30 feet

AQUIFERS:
Gravel from 8 to 30 feet

WATER LEVEL:
15 feet

PUMPING EQUIPMENT: Type F. M. centrifugal H.P. 40
Capacity 1000 G.P.M.

WELL TESTS:
Drawdown 3 ft. after _____ hours _____ 1000 G.P.M.
Drawdown _____ ft. after _____ hours _____ G.P.M.

USE OF WATER Irrigation (84 acres) Temp. _____ °F. _____, 19____

SOURCE OF INFORMATION GR- 293

DRILLER or DIGGER _____

ADDITIONAL DATA:

Log NA Water Level Measurements _____ Chemical Analysis _____ Aquifer Test _____

REMARKS: