


OWNER: Elmer H. Busby
MAILING ADDRESS: Route 1, Box 70
CITY AND STATE: Independence, Oregon

LOCATION OF WELL: Owner's No. ^M ^R
SW 1/4 NW 1/4 Sec. 13 T. 9 S., R. 4 W., W.M.
Bearing and distance from section or subdivision
corner 9.80 chs. N. of 1/4 Cor. E. 1.00 ft. N.
120 ft.

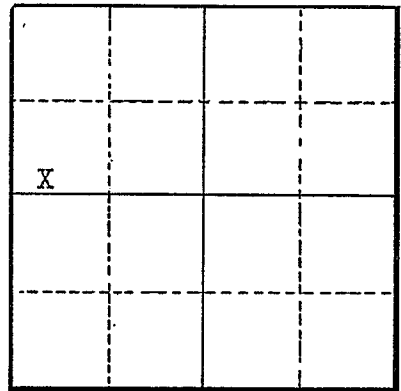

Section 13

Altitude at well
TYPE OF WELL: Driven Date Constructed 1944
Depth drilled 32 ft. Depth cased 32 ft.

CASING RECORD:

2 inch casing set to 32 feet

FINISH:

10 - 3/8" holes per foot from 0 to 28 ft.

AQUIFERS:

WATER LEVEL:

20 feet below surface

PUMPING EQUIPMENT: Type Montgomery Ward H.P. 2
Capacity 50 G.P.M.

WELL TESTS:

Drawdown ft. after hours G.P.M.
Drawdown ft. after hours G.P.M.

USE OF WATER Irrigation Temp. °F. 19

SOURCE OF INFORMATION Well Registration Statement Cert. # GR-3559

DRILLER or DIGGER Elmer H. Busby

ADDITIONAL DATA:

Log ^X Water Level Measurements Chemical Analysis Aquifer Test

REMARKS:

Log:
Alluvial soil
Gravel