

STATE ENGINEER
Salem, Oregon

Well Record

STATE WELL NO. 9/4W-14B
COUNTY Polk
APPLICATION NO. GR-1278

GR- 1235

Polk
3877

OWNER: Zeb E. Millhouser


MAILING ADDRESS: Rt. 1, Box 113

LOCATION OF WELL: Owner's No. #1

CITY AND STATE: Independence, Oregon

NW ¼ NE ¼ Sec. 14 T. 9 S., R. 4 W., W.M.

Bearing and distance from section or subdivision
corner 1320' S. & 2250' W. from NE cor. Sec. 14.

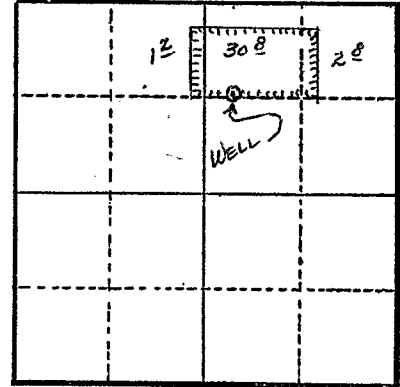

Section 14

Altitude at well _____

TYPE OF WELL: Drilled Date Constructed 1946

Depth drilled 37 ft. Depth cased 37 ft.

CASING RECORD:

10 inch

FINISH:

Perforated: torch slots from 27 to 37 ft.

AQUIFERS:

WATER LEVEL:

15 ft. (Spring)

PUMPING EQUIPMENT: Type 3 x 4 in. Cent. H.P. 20
Capacity 300 G.P.M.

WELL TESTS:

Drawdown 7 ft. after _____ hours 300 G.P.M.

Drawdown _____ ft. after _____ hours _____ G.P.M.

USE OF WATER Irrigation Temp. _____ °F., 19 _____

SOURCE OF INFORMATION G. R. Record

DRILLER or DIGGER Bill Hamilton

ADDITIONAL DATA:

Log _____ Water Level Measurements _____ Chemical Analysis _____ Aquifer Test _____

REMARKS:

Log: Top soil 0 to 20 ft.
Gravel 20 to 37 ft.

Irrigation of 34.8 acres.