

STATE ENGINEER  
Salem, Oregon

# Well Record

STATE WELL NO. 9/4W-14C  
COUNTY Polk  
APPLICATION NO. GR-1279

GR- 1236

3878

OWNER: Zeb E. Millhouser


MAILING ADDRESS: Rt. 1, Box 113

LOCATION OF WELL: Owner's No. #2

CITY AND STATE: Independence, Oregon

NE 1/4 NW 1/4 Sec. 14 T. 9 S, R. 4 W., W.M.

Bearing and distance from section or subdivision corner 1070' S. & 2800' W. from NE cor. Sec. 14.

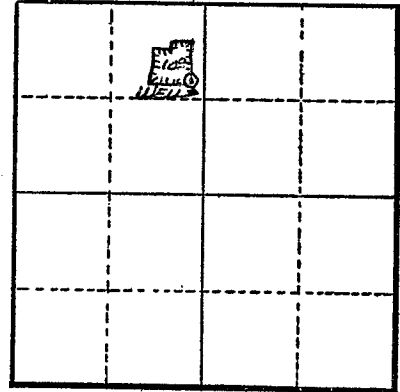

Section 14

Altitude at well

TYPE OF WELL: Drilled Date Constructed 1950

Depth drilled 35 ft. Depth cased 35 ft.

### CASING RECORD:

8 inch

### FINISH:

Perforated from 25 to 35 ft.

### AQUIFERS:

### WATER LEVEL:

12 ft. (Spring)

PUMPING EQUIPMENT: Type 1 1/2 x 2 in. Cent. H.P. 5  
Capacity 200 G.P.M.

### WELL TESTS:

Drawdown 19 ft. after April hours 200 G.P.M.  
Drawdown ft. after hours G.P.M.

USE OF WATER Irrigation Temp. °F. 19

SOURCE OF INFORMATION G. R. Record

DRILLER or DIGGER Art. Clinton

### ADDITIONAL DATA:

Log Water Level Measurements Chemical Analysis Aquifer Test

### REMARKS:

Log: Top soil 0 to 20 ft.  
Gravel 20 to 35 ft.

Irrigation of 10 acres.