

STATE ENGINEER
Salem, Oregon

Well Record

STATE WELL NO. 9/LW-14H
COUNTY Polk
APPLICATION NO. GR-3143

3880

OWNER: Elbert N. Kuhns


MAILING ADDRESS: Route 1, Box 74 A

LOCATION OF WELL: Owner's No. _____

CITY AND STATE: Independence, Oregon

SE ¼ NE ¼ Sec. 14 T. 2 ^N S., R. 4 ^E W., W.M.

Bearing and distance from section or subdivision corner 840' W. and 100' N.

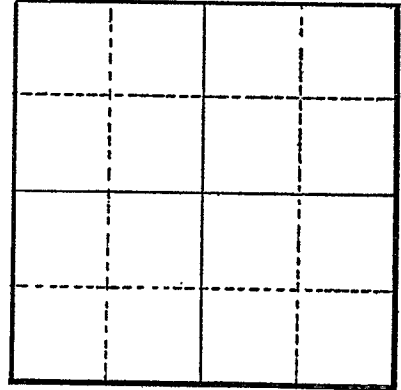

Section _____

Altitude at well _____

TYPE OF WELL: drilled Date Constructed 1951

Depth drilled 40' Depth cased 40'

CASING RECORD:

6"

FINISH:

AQUIFERS:

WATER LEVEL:

25'

PUMPING EQUIPMENT: Type Pacific 2½" Suction 2" outlet _____ H.P. 7½
Capacity 200 G.P.M.

WELL TESTS:

Drawdown 2½ ft. after _____ hours pumping 200 G.P.M.
Drawdown _____ ft. after _____ hours _____ G.P.M.

USE OF WATER Irrigation Temp. _____ °F. _____, 19_____

SOURCE OF INFORMATION GR-2947

DRILLER or DIGGER _____

ADDITIONAL DATA:

Log _____ Water Level Measurements _____ Chemical Analysis _____ Aquifer Test _____

REMARKS: