

STATE ENGINEER
Salem, Oregon

Well Record

Polk
3881

STATE WELL NO. 9/4W-14H
COUNTY Polk
APPLICATION NO. GR-1396

GR- 1352

OWNER: Arthur A. Cook


MAILING ADDRESS: Rt. 1, Box 73 A

LOCATION OF WELL: Owner's No. #1

CITY AND STATE: Independence, Oregon

SE 1/4 NE 1/4 Sec. 14 T. 9 S., R. 4 W., W.M.

Bearing and distance from section or subdivision corner 3320' E. & 630' S. from NE cor. D1C of A. V. McCarthy.

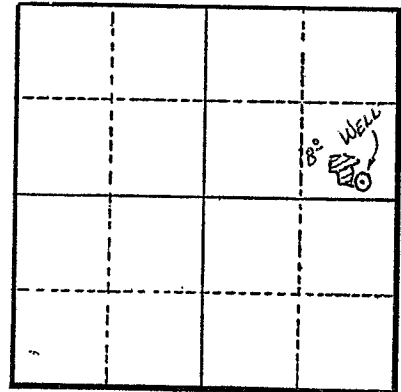

Section 14

Altitude at well 175 ft.

TYPE OF WELL: Drilled Date Constructed 1947

Depth drilled 40 ft. Depth cased 40 ft.

CASING RECORD:

10 inch ~~4 inch~~

FINISH:

AQUIFERS:

WATER LEVEL:

23 ft. (Summer)

PUMPING EQUIPMENT: Type Pacific 1 1/4 in. Cent.

H.P. 5

Capacity 100 G.P.M.

WELL TESTS:

Drawdown ft. after hours G.P.M.

Drawdown ft. after hours G.P.M.

USE OF WATER Irrigation Temp. °F., 19.....

SOURCE OF INFORMATION G. R. Record

DRILLER or DIGGER Bill Hamilton

ADDITIONAL DATA:

Log N.A. Water Level Measurements Chemical Analysis Aquifer Test

REMARKS:

Irrigation of 8 acres.