

STATE ENGINEER
Salem, Oregon

Well Record

Polk
39738

STATE WELL NO. 9/4W-23
COUNTY POLK
APPLICATION NO. GR-2495

OWNER: Ruby Hayden Trustee

MAILING ADDRESS: 4535 Dallas Road


LOCATION OF WELL: Owner's No. _____

CITY AND STATE: Salem, Oregon

..... $\frac{1}{4}$ $\frac{1}{4}$ Sec. 23 T. 9 S., R. 4 W., W.M.

Bearing and distance from section or subdivision

corner 17 ch. N. & 8 ch W.

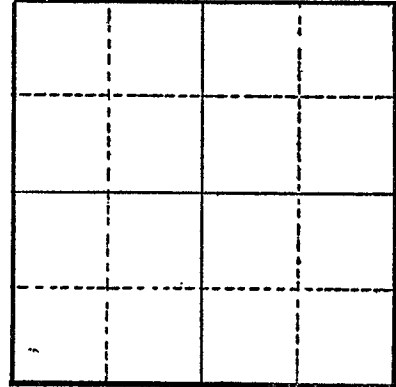

Section _____

Altitude at well _____

TYPE OF WELL: Drilled Date Constructed 1945

Depth drilled 30 Depth cased _____

CASING RECORD:

FINISH:

AQUIFERS:

WATER LEVEL:
16-feet

PUMPING EQUIPMENT: Type Built-in H.P. 15
Capacity 360 G.P.M.

WELL TESTS:
Drawdown 10 ft. after _____ hours Pumping 360 G.P.M.
Drawdown _____ ft. after _____ hours _____ G.P.M.

USE OF WATER Irrigation Temp. _____ °F. _____, 19

SOURCE OF INFORMATION GR-2362

DRILLER or DIGGER _____

ADDITIONAL DATA:

Log _____ Water Level Measurements _____ Chemical Analysis _____ Aquifer Test _____

REMARKS: