


STATE ENGINEER
Salem, Oregon

Well Record *Polk* STATE WELL NO. *10/4W-2E*
2106 COUNTY *Polk*
APPLICATION NO. *GR-4061*

OWNER: *Donald Behrends* MAILING ADDRESS: *130 N. Chicago St.*
CITY AND STATE: *Albany, Oregon*

LOCATION OF WELL: Owner's No. _____
SW 1/4 NW 1/4 Sec. 2 T. 10 S., R. 4 W., W.M.
Bearing and distance from section or subdivision
corner *2640 ft. E. 534°50' W. 2640 ft. to NW*
cor. of Sec. 2

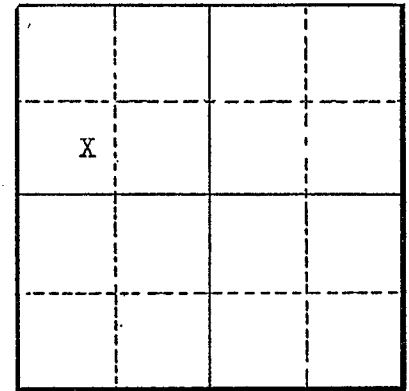

Altitude at well _____
TYPE OF WELL: *Drilled* Date Constructed *1946*
Depth drilled *32 ft.* Depth cased _____

CASING RECORD:

FINISH:

AQUIFERS:

WATER LEVEL:

15 ft. below surface

PUMPING EQUIPMENT: Type *Fairbanks Morse* H.P. *15*
Capacity _____ G.P.M.

WELL TESTS:

Drawdown _____ ft. after _____ hours _____ G.P.M.
Drawdown _____ ft. after _____ hours _____ G.P.M.

USE OF WATER *Irrigation* Temp. _____ °F. _____, 19
SOURCE OF INFORMATION *Well Registration Statement* Cert. # *GR-3660*

DRILLER or DIGGER
ADDITIONAL DATA:

Log _____ Water Level Measurements _____ Chemical Analysis _____ Aquifer Test _____

REMARKS: