

STATE ENGINEER
Salem, Oregon

POD ID
18827
POLK
51040


Well Record

GR- 1063

STATE WELL NO. 9/3W-7M(1)
COUNTY Polk
APPLICATION NO. GR- 1103

OWNER: John I. Haas, Inc. of Baltimore, Md. MAILING ADDRESS: Rt. 1, Box 3
Alluvial Hop Farm CITY AND STATE: Independence, Oregon

LOCATION OF WELL; Owner's No. #2
NW 1/4 SW 1/4 Sec. 7 T. 9 S., R. 3 W., W.M.
Bearing and distance from section or subdivision
corner S86°54'E. 20.48 ch. from NW 1/4 of SW 1/4 of
Section 7.

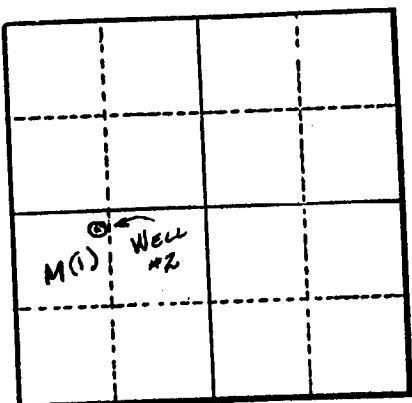

Section 7

Altitude at well 176 ft.
TYPE OF WELL: Drilled Date Constructed 1949
Depth drilled 30 ft. Depth cased 30 ft.

CASING RECORD:
16 in. concrete tile

FINISH:

AQUIFERS:

WATER LEVEL:
17 ft.

PUMPING EQUIPMENT: Type F. M. Cent. 4 x 5 H.P. 50
Capacity 900 G.P.M.

WELL TESTS:
Drawdown 2 ft. after 1200 hours G.P.M.
Drawdown ft. after hours G.P.M.

USE OF WATER Irrigation Temp. °F., 19
SOURCE OF INFORMATION G. R. Record

DRILLER or DIGGER
ADDITIONAL DATA:
Log Water Level Measurements Chemical Analysis Aquifer Test

REMARKS:
Log: River bottom soil 0 to 15 ft.
Sand & gravel 15 to 30 ft.

Irrigation of 48 ft.