

STATE OF OREGON
WATER SUPPLY WELL REPORT
(as required by ORS 537.765)

(WELL I.D.)# L 81335
(START CARD) # 183785

Instructions for completing this report are on the last page of this form.

(1) OWNER: Well Number **4170**
Name **Ken McKinney**
Address **12775 Kings Valley Hwy.**
City **Monmouth** State **Oregon** Zip **97361**

(2) TYPE OF WORK
 New Well Deepening Alteration (repair/recondition) Abandonment

(3) DRILL METHOD:
 Rotary Air Rotary Mud Cable Auger
 Other

(4) PROPOSED USE:
 Domestic Community Industrial Irrigation
 Thermal Injection Livestock Other

(5) BORE HOLE CONSTRUCTION:
Special Construction approval Yes No Depth of Completed Well **148** ft.
Explosives used Yes No Type _____ Amount _____

HOLE			SEAL			Sacks or pounds
Diameter	From	To	Material	From	To	
10	0	19	Bentonite	0	19	8 sacks
6	19	148				

How was seal placed: Method A B C D E
 Other **Poured dry**
Backfill placed from _____ ft. to _____ ft. Material _____
Gravel placed from _____ ft. to _____ ft. Size of gravel _____

Casing/Liner	Diameter	From	To	Gauge	Steel	Plastic	Welded	Threaded
Casing: 6		+1	19	250	<input checked="" type="checkbox"/>	<input type="checkbox"/>	<input type="checkbox"/>	<input type="checkbox"/>
Liner: 4-1/2		0	148	160	<input type="checkbox"/>	<input checked="" type="checkbox"/>	<input type="checkbox"/>	<input type="checkbox"/>

Final location of shoe(s) _____

(7) PERFORATIONS/SCREENS:
 Perforations Method **Drilled**
 Screens Type _____ Material _____

From	To	Slot size	Number	Diameter	Tele/pipe size	Casing	Liner
0	148		1800	1/4		<input type="checkbox"/>	<input checked="" type="checkbox"/>

(8) WELL TESTS: Minimum testing time is 1 hour
 Pump Bailer Air Flowing
Yield gal/min _____ Drawdown _____ Drill stem at _____ Time _____
3 gpm _____ 148 _____ 1 hr.

Temperature of water **54** Depth Artesian Flow Found _____
Was a water analysis done? Yes By whom _____
Did any strata contain water not suitable for intended use? Too little
 Salty Muddy Odor Colored Other _____
Depth of strata: _____

(9) LOCATION OF WELL by legal description:
County **Polk** Latitude _____ Longitude _____
Township **9 S** Range **6 W** WM.
Section **33 NE** 1/4 **NE** 1/4
Tax Lot **204** Lot _____ Block _____ Subdivision _____
Street Address of Well (or nearest address) **12775 Kings Valley Hwy, Monmouth, OR 97361**


(10) STATIC WATER LEVEL:
17 ft. below land surface. Date **4/21/2006**
Artesian pressure _____ lb. per square inch. Date _____

(11) WATER BEARING ZONES:
Depth at which water was first found **65**

From	To	Estimated Flow Rate	SWL
65	66	1-1/2	17
112	113	1-1/2	17

(12) WELL LOG:
Ground Elevation _____

Material	From	To	SWL
Topsoil	0	2	
Brown clay	2	12	
Grey sandstone (fine)	12	148	

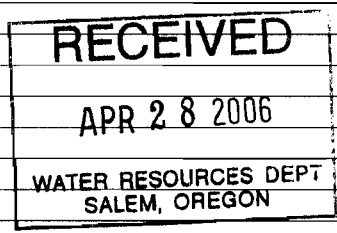

JONES DRILLING CO., INC.
29400 SANTIAM HWY.
LEBANON, OR 97355
541-367-2560 541-451-2686
1-800-915-8388

Date started **4/21/2006** Completed **4/21/2006**

(unbonded) Water Well Constructor Certification:
I certify that the work I performed on the construction, alteration, or abandonment of this well is in compliance with Oregon water supply well construction standards. Materials used and information reported above are true to the best of my knowledge and belief.
Signed WWC Number **1411** Date **4/25/2006**

(bonded) Water Well Constructor Certification:
I accept responsibility for the construction, alteration, or abandonment work performed on this well during the construction dates reported above. All work performed during this time is in compliance with Oregon water supply well construction standards. This report is true to the best of my knowledge and belief.
Signed WWC Number **1684** Date **4/25/2006**