

STATE OF OREGON
WATER SUPPLY WELL REPORT

(as required by ORS 537.765 & OAR 690-205-0210)

WELL LABEL # L 82051

START CARD # 183630

(1) LAND OWNER Owner Well I.D. 2

First Name Last Name
Company CITY OF INDEPENDENCE
Address PO BOX 1142
City INDEPENDENCE State OR Zip 97351

(2) TYPE OF WORK [X] New Well [] Deepening [] Conversion
[] Alteration (repair/recondition) [] Abandonment

(3) DRILL METHOD
[X] Rotary Air [] Rotary Mud [] Cable [] Auger [] Cable Mud
[] Reverse Rotary [] Other

(4) PROPOSED USE [] Domestic [] Irrigation [X] Community
[] Industrial/ Commercial [] Livestock [] Dewatering
[] Thermal [] Injection [] Other

(5) BORE HOLE CONSTRUCTION Special Standard [] Attach copy
Depth of Completed Well 80 ft.

Table with columns: Dia, From, To, Material, SEAL, Amt, sacks/lbs. Row 1: 12, 0, 34, Cement, 0, 34, 17, S

How was seal placed: Method [] A [] B [X] C [] D [] E
[] Other

Backfill placed from ft. to ft. Material

Filter pack from ft. to ft. Material Size

Explosives used: [] Yes Type Amount

(6) CASING/LINER Table with columns: Casing, Liner, Dia, From, To, Gauge, Stl, Plstc, Wld, Thrd

Shoe [X] Inside [] Outside [] Other Location of shoe(s)
Temp casing [] Yes Dia From To

(7) PERFORATIONS/SCREENS

Perforations Method Mills knife
Screens Type Material

Table with columns: Perf/ Screen, Casing/ Liner, Dia, From, To, Scrm/slot width, Slot length, # of slots, Tele/ pipe size

(8) WELL TESTS: Minimum testing time is 1 hour

Table with columns: Pump/Bailer/Air/Flowing Artesian, Yield gal/min, Drawdown, Drill stem/Pump depth, Duration (hr)

Temperature 54 °F Lab analysis [] Yes By

Table with columns: Water quality concerns?, From, To, Description, Amount, Units

(9) LOCATION OF WELL (legal description)

County POLK Twp 8 S N/S Range 4 W E/W WM
Sec 28 SE 1/4 of the NW 1/4 Tax Lot 3000
Tax Map Number Lot
Lat ° 0 ' " or DMS or DD
Long ° 0 ' " or DMS or DD
Street address of well Nearest address

RIVER OAK RD; END OF RD; N OF BRIARRD

(10) STATIC WATER LEVEL


Table with columns: Existing Well / Predeepening, Date, SWL(psi), + SWL(ft)

WATER BEARING ZONES Depth water was first found 32

Table with columns: SWL Date, From, To, Est Flow, SWL(psi), + SWL(ft)

(11) WELL LOG

Table with columns: Material, From, To, Ground Elevation

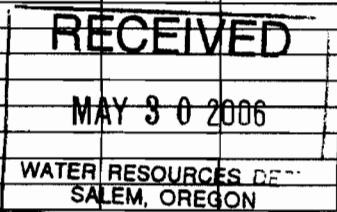

Date Started 03-27-2006 Completed 04-20-2006

(unbonded) Water Well Constructor Certification

I certify that the work I performed on the construction, deepening, alteration, or abandonment of this well is in compliance with Oregon water supply well construction standards.

License Number 1629 Date 05-02-2006
Password: (if filing electronically)
Signed

(bonded) Water Well Constructor Certification

I accept responsibility for the construction, deepening, alteration, or abandonment work performed on this well during the construction dates reported above.

License Number 1273 Date 05-02-2006
Password: (if filing electronically) ****
Signed Floyd Sepp
Contact Info (optional)