

STATE ENGINEER
Salem, Oregon


Well Record

STATE WELL NO. 6/3W-6R(1)
COUNTY Polk
APPLICATION NO. GR-139
990

OWNER: Gust Janzen MAILING ADDRESS: Rt. 1

LOCATION OF WELL: Owner's No. 1 CITY AND STATE: Dayton, Oregon

NE 1/4 SE 1/4 Sec. 6 T. 6 N. S. R. 3 W, W.M.
Bearing and distance from section or subdivision
corner 1100' N. & 260' W. from SE cor. Sec. 6,
or 330' S. of N. prop. line & 200'

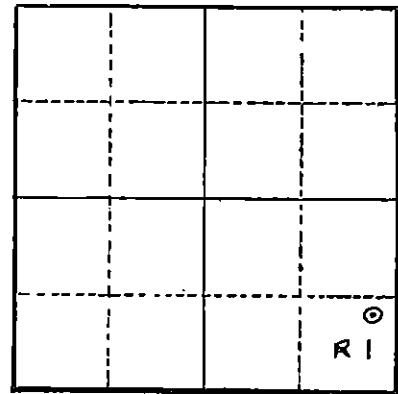

Altitude at well 180 ft. Interpolated

TYPE OF WELL: drilled Date Constructed Oct., 1952

Depth drilled 142 Depth cased 122

Section 6

CASING RECORD: 10 inch casing set from 0 to 122 ft.

FINISH: none

AQUIFERS: Rock, broken from 122 to 142 ft.

WATER LEVEL: Flwing well - 3gpm 5 lbs shot in pressure Feb. 1953

PUMPING EQUIPMENT: Type Fairbanks-Morse 6 bowls at 135 ft. turbine H.P. 7 1/2
Capacity 110 G.P.M.

WELL TESTS:
Drawdown 115 ft. after 80 hours G.P.M.
Drawdown 135 ft. after 110 hours G.P.M.

USE OF WATER irrigation 30 acres Temp. °F. 19

SOURCE OF INFORMATION Registration statement GR-139

DRILLER or DIGGER J. T. Miller

ADDITIONAL DATA:

Log Water Level Measurements Chemical Analysis Aquifer Test

REMARKS:



Oregon Water Resources Department
 725 Summer Street NE, Suite A
 Salem Oregon 97301
 (503) 986-0900
 www.oregon.gov/owrd

Application for Well ID Number

RECEIVED

MAY 14 2024

OWRD

Do not complete if the well already has a Well Identification Number.

I. OWNER INFORMATION

Current Owner Name (please print): TPWC INC / Lingua Fran Winery
 Mailing Address: 235 N Bloomfield Rd
 City, State, Zip: Canadaigua, NY, 14424
 Mail Well ID to: SAME AS ABOVE In Care Of (C/O)
 Name & Address: TPWC INC 9675 Hopewell Rd NW
 City, State, Zip: Salem, OR 97304

II. WELL LOCATION INFORMATION (Please fill out as completely as possible)

Township: 6 S (North / South) Range: 3 W (East / West) Section: 6 SE 1/4 of the SE 1/4
 Tax Lot (usually last 3-5 numbers of Tax Map #): 100 County POLK
 GPS Coordinates: 45.074198, -123.093318
 Street Address of Well, City: 9675 Hopewell Rd NW Salem, OR 97304
 If the property had a different street address in the past: Route 1, Dayton OR 97114

III. GENERAL WELL INFORMATION (Please fill out as completely as possible, AND attach copy of Well Report, if available)

Use of Well (domestic, irrigation, commercial, industrial, monitoring): Irrigation
 Date Well Constructed (or property built): OCT 1952 Total Well Depth: 142' Casing Diameter: 10"
 Owner at time the well was constructed (if known): Gust Janzen Well Report # (if known): POLK 990
 Other Information: Inspector installed Tag - L95019

SUBMITTED BY (please print): OWRD Well Inspector Ryan Pillsbury
 PHONE: _____ EMAIL &/or FAX: _____

To send the completed application, you may MAIL it to: Oregon Water Resources Dept. 725 Summer St NE, Suite A, Salem, Oregon 97301.
 Or EMAIL the completed PDF form to: Ladeena.K.Ashley@water.oregon.gov, or FAX it to: (503) 986-0902.

For Official Use Only by the Oregon Water Resources Department:

Received Date: <u>5-14-2024</u>	Well Report Number: <u>POLK 990</u>	Well Identification #: <u>L-95019</u>
------------------------------------	--	--