

STATE ENGINEER
Salem, Oregon

SHER
263

OBSERVATION WELL Well Record

STATE WELL NO. 1N/17-4L(1)
COUNTY Sherman
APPLICATION NO. U- 864

OWNER: Philip G. O'Meara


MAILING ADDRESS: _____

LOCATION OF WELL: Owner's No. _____

CITY AND STATE: Wasco, Oregon

NE $\frac{1}{4}$ SW $\frac{1}{4}$ Sec. 4 T. 1 ~~NS~~R. 17 ~~SW~~E. W.M.

Bearing and distance from section or subdivision corner 411' W. & 269' S. of center of sec. 4

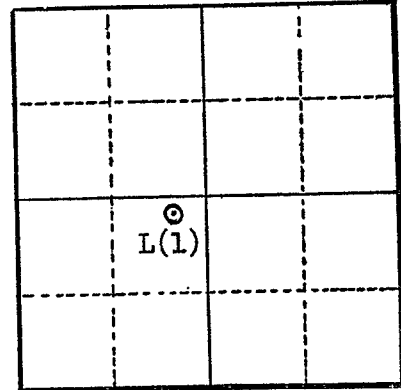

Section 4

Altitude at well _____

TYPE OF WELL: Drilled Date Constructed 10/54-4/55

Depth drilled 712' Depth cased 8'

CASING RECORD:
8 inch

FINISH:

AQUIFERS:

⁶⁵
Basalt from 649 to 712 feet

WATER LEVEL:
6 feet

PUMPING EQUIPMENT: Type Worthington turbine H.P. 20
Capacity 312 G.P.M.

WELL TESTS:
Drawdown 77 ft. after 4 hours 640 G.P.M.
Drawdown _____ ft. after _____ hours _____ G.P.M.

USE OF WATER Irrigation Temp. 62 °F. April, 1955

SOURCE OF INFORMATION U- 752

DRILLER or DIGGER E. E. Shull

ADDITIONAL DATA:

Log Water Level Measurements _____ Chemical Analysis _____ Aquifer Test _____

REMARKS:

