

STATE ENGINEER
Salem, Oregon

SEER
301

Well Record

STATE WELL NO. 2N/16-33K(1)
COUNTY Sherman
APPLICATION NO. U- 562

OWNER: H. A. & Rosalie White

MAILING
ADDRESS:


LOCATION OF WELL: Owner's No.

CITY AND
STATE:

Wasco, Oregon

NW 1/4 SE 1/4 Sec. 33 T. 2 N. 16 E. W.M.

Bearing and distance from section or subdivision
corner

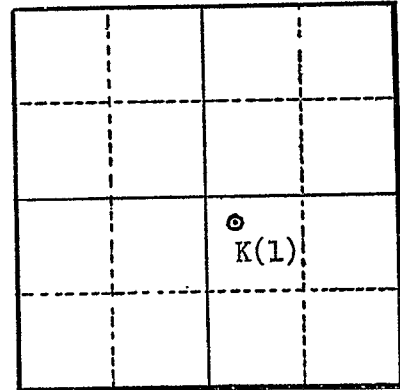

Section 33

Altitude at well

TYPE OF WELL: Dug Date Constructed

Depth drilled 40' Depth cased

CASING RECORD:

12 foot in diameter

FINISH:

AQUIFERS:

WATER LEVEL:
Flows

PUMPING EQUIPMENT: Type Centrifugal H.P. 10
Capacity 130 G.P.M.

WELL TESTS:

Drawdown ft. after hours G.P.M.
Drawdown ft. after hours G.P.M.

USE OF WATER Irrigation Temp. °F. 19

SOURCE OF INFORMATION U- 510

DRILLER or DIGGER Owner

ADDITIONAL DATA:

Log X Water Level Measurements Chemical Analysis Aquifer Test

REMARKS:

Soil & clay
Rock

0 to 10
10 to 40

State Well No. 2N/16-33K(1)

County Sherman

Application No. U 562

Water Level Record

OWNER: H. A. & ROSALIE WHITE OWNER'S NO. _____

Description of measuring point: Concret. floor of wall house
20' below LSP

[illegible]

REMARKS: _____