

RECEIVED

STATE OF OREGON  
WATER SUPPLY WELL REPORT  
(as required by ORS 537.765)

MAR 15 2005

WELL I.D. # L N/A

START CARD # 172756

Instructions for completing this report are on the back page of this report.

WATER RESOURCES DEPT

(1) LAND OWNER  
Name City of Grass Valley Well Number \_\_\_\_\_  
Address PO Box 191  
City Grass Valley State OR Zip 97029

(2) TYPE OF WORK  New Well  
 Deepening  Alteration (repair/recondition)  Abandonment  Conversion

(3) DRILL METHOD  
 Rotary Air  Rotary Mud  Cable  Auger  Cable Mud  
 Other \_\_\_\_\_

(4) PROPOSED USE  
 Domestic  Community  Industrial  Irrigation  
 Thermal  Injection  Livestock  Other \_\_\_\_\_

(5) BORE HOLE CONSTRUCTION Special Construction:  Yes  No  
Depth of Completed Well -0- ft.  
Explosives used:  Yes  No Type \_\_\_\_\_ Amount \_\_\_\_\_

BORE HOLE SEAL  
Table with columns: Diameter, From, To, Material, From, To, Sacks or Pounds

How was seal placed: Method  A  B  C  D  E  
 Other \_\_\_\_\_  
Backfill placed from \_\_\_\_\_ ft. to \_\_\_\_\_ ft. Material \_\_\_\_\_  
Gravel placed from \_\_\_\_\_ ft. to \_\_\_\_\_ ft. Size of gravel \_\_\_\_\_

(6) CASING/LINER  
Table with columns: Diameter, From, To, Gauge, Steel, Plastic, Welded, Threaded

Drive Shoe used  Inside  Outside  None  
Final location of shoe(s) \_\_\_\_\_

(7) PERFORATIONS/SCREENS  
Table with columns: From, To, Slot Size, Number, Diameter, Tele/pipe size, Casing, Liner

(8) WELL TESTS: Minimum testing time is 1 hour  
 Pump  Bailer  Air  Flowing Artesian  
Yield gal/min \_\_\_\_\_ Drawdown \_\_\_\_\_ Drill stem at \_\_\_\_\_ Time \_\_\_\_\_  
Temperature of water \_\_\_\_\_ Depth Artesian Flow Found \_\_\_\_\_  
Was a water analysis done?  Yes By whom \_\_\_\_\_  
Did any strata contain water not suitable for intended use?  Too little  
 Salty  Muddy  Odor  Colored  Other \_\_\_\_\_  
Depth of strata: \_\_\_\_\_

(9) LOCATION OF WELL (legal description)  
County Sherman  
Tax Lot 3502 Lot \_\_\_\_\_  
Township 2S N or S Range 16E E or W WM  
Section 27 NE 1/4 SE 1/4

Lat \_\_\_\_\_ " or \_\_\_\_\_ (degrees or decimal)  
Long \_\_\_\_\_ " or \_\_\_\_\_ (degrees or decimal)

Street Address of Well (or nearest address) Sharp Street  
Grass Valley, OR

(10) STATIC WATER LEVEL  
97 ft. below land surface. Date 03/09/2005  
\_\_\_\_\_ ft. below land surface. Date \_\_\_\_\_  
Artesian pressure \_\_\_\_\_ lb. per square inch Date \_\_\_\_\_

(11) WATER BEARING ZONES  
Table with columns: From, To, Estimated Flow Rate, SWL

(12) WELL LOG  
Ground Elevation \_\_\_\_\_  
Material From To SWL  
Existing well "Sher 50061"  
Original drill log enclosed  
Engineers report of video inspection 02/24/03  
Concrete Vault removed by Contractor  
Existing 8" Casing below grade -2ft  
8" casing bent/tipped, not accessible 2-12 ft.  
8" bore hole, open bore to +183' (SWL 97')  
Crushed rock fill in 6" bore 344-210 ft.  
Cement grout (50 sks mix) 210-1 ft.  
Crushed rock, parking lot 1-0  
Date Started 03/09/2005 Completed 03/09/2005

(unbonded) Water Well Constructor Certification  
I certify that the work I performed on the construction, deepening, alteration, or abandonment of this well is in compliance with Oregon water supply well construction standards. Materials used and information reported above are true to the best of my knowledge and belief.  
WWC Number \_\_\_\_\_ Date \_\_\_\_\_  
Signed \_\_\_\_\_

(bonded) Water Well Constructor Certification  
I accept responsibility for the construction, deepening, alteration, or abandonment work performed on this well during the construction dates reported above. All work performed during this time is in compliance with Oregon water supply well construction standards. This report is true to the best of my knowledge and belief.  
WWC Number 573 Date 03/10/2005  
Signed \_\_\_\_\_

RECEIVED COPY

MAR 15 2005

CITY OF GRASS VALLEY WELL  
WATER RESOURCES DEPT  
SALEM, OREGONBennett & Sons, Contractor  
The Dalles, OregonClyde Root, Driller  
Mosier, Oregon

Well #1

Well No 1  
South Well  
Old Well

0-2	Soil
2-44	Soft rock
44-57	Soft. Probably sandstone. A small amount of water at 55-60 ft.
67-96	Very hard rock
96-167	Medium hard rock
167-177	A little softer rock
177-216	Hard rock
216-234	Medium hard rock
234-244	Blue clay
244-260	Brown clay
260-266	Green clay
266-280	White clay
280-303	Tan clay.

At 264 ft the well pump tested 20 gpm. At 292 ft the well pump tested 30 gpm. At this point drilling was discontinued. When drilling was continued 100 ft of 6 inch pipe was installed, the top of this sleeve being 184 ft from the top of the well.


303-344 Soft rock. The water level dropped 30 ft from 12 ft to 42 ft at the 334-8 ft depth and then dropped 58 ft from 42 ft to 100 ft at the 342 ft depth.

Water level 100 ft.

Pump tested 100 gpm.

Amount of casing at the surface of the well not given.

Drilled 1949

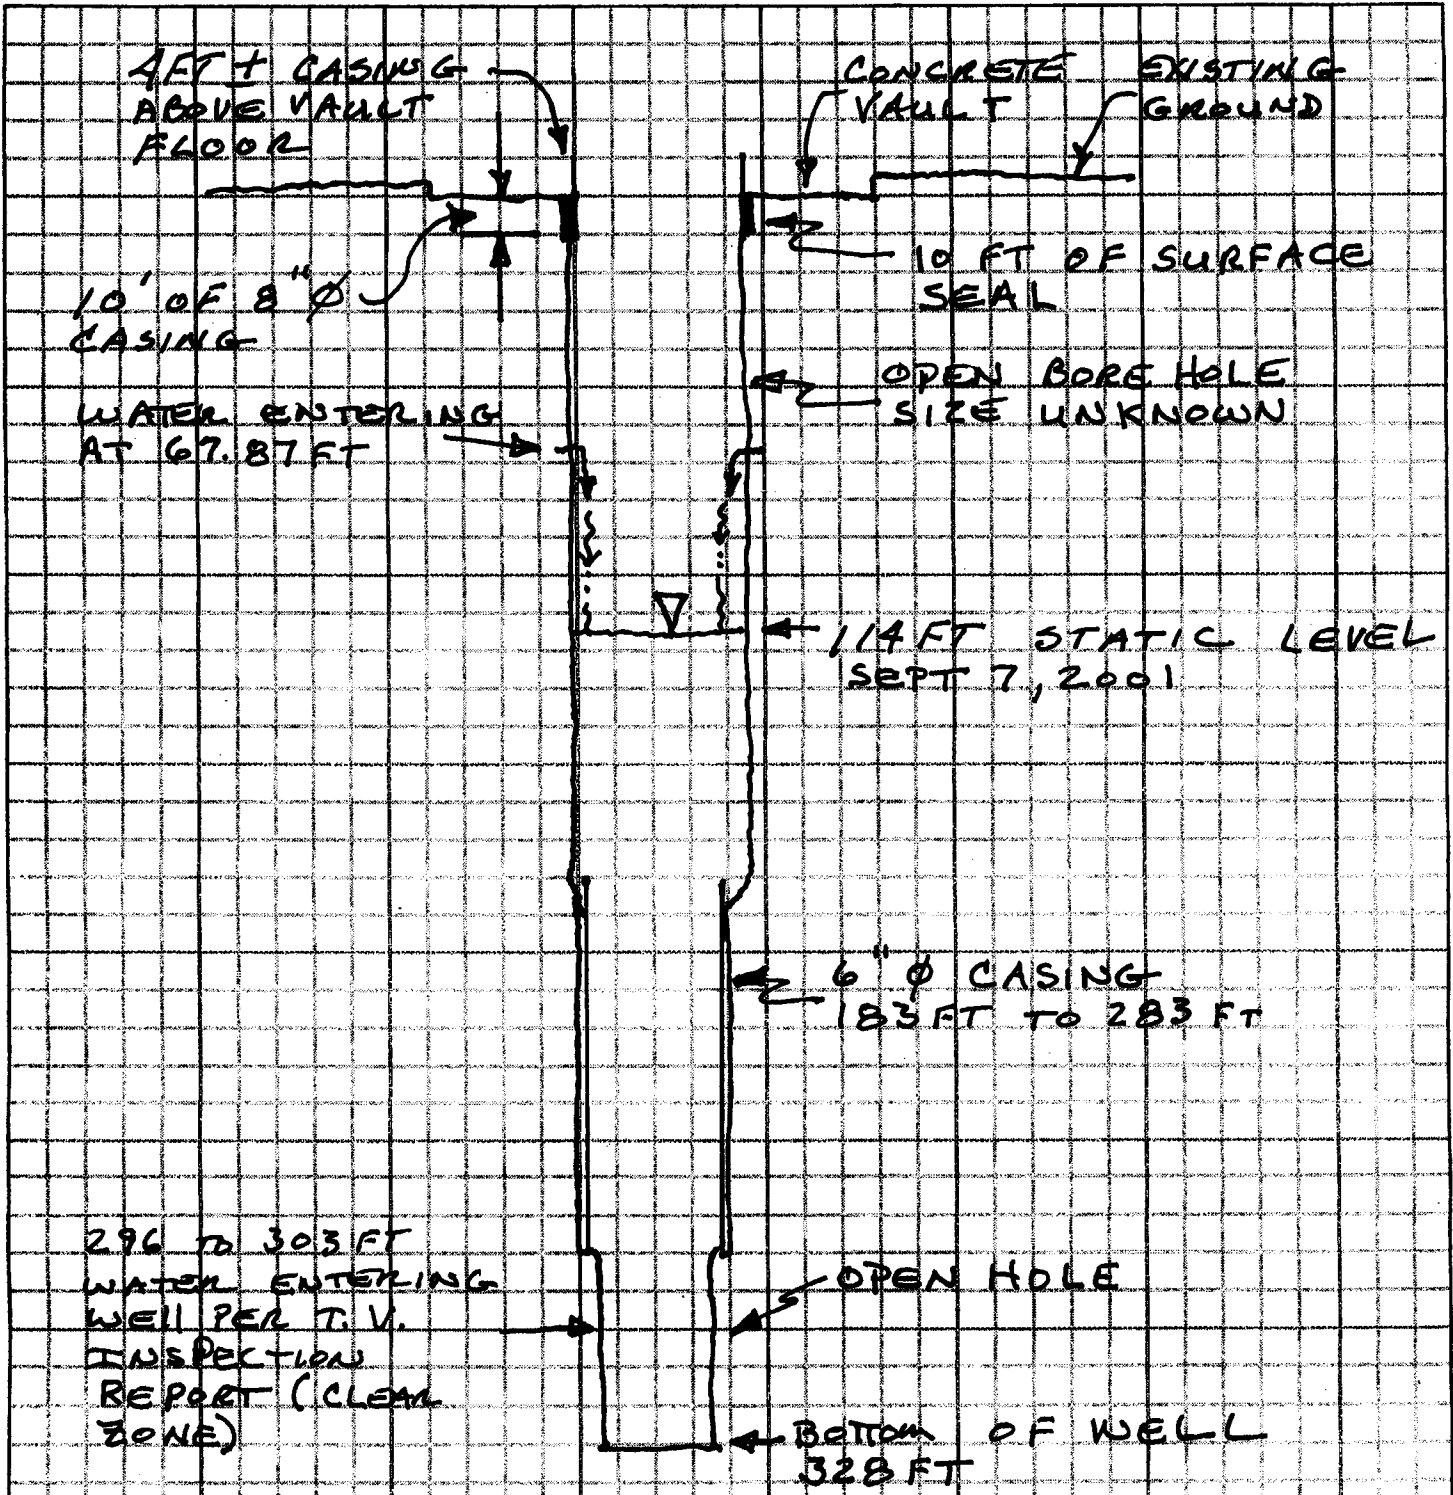

WELL No. 1  
(SOUTH WELL)

**RECEIVED**

MAR 15 2005

WATER RESOURCES DEPT  
SALEM, OREGON