





Oregon Water Resources Department  
Groundwater Use Recording Mapping Tool

725 Summer St NE, Sale

Step 1: Search for Well

Step 2: Create Well  
Map

Mark Well Point and  
Create Map:

Zoom in closer to the well  
location, if needed.  
Mark the location of the well  
by either of these two  
methods:

A. Drawing on the map  
using the draw tool

Click on Icon and draw  
a point on the map

B. Type in the GPS Decimal  
Degrees:

GPS  
Latitude: 45.6684

GPS  
Longitude: -120.8335

Mark  
Point Clear Point

[Converter](#)

Results:

Latitude: 45.6684  
Longitude: -120.8335

Complete the form:


Submitted  
by:

Address  
of Well:

City:

Special  
Notes:

Make Map

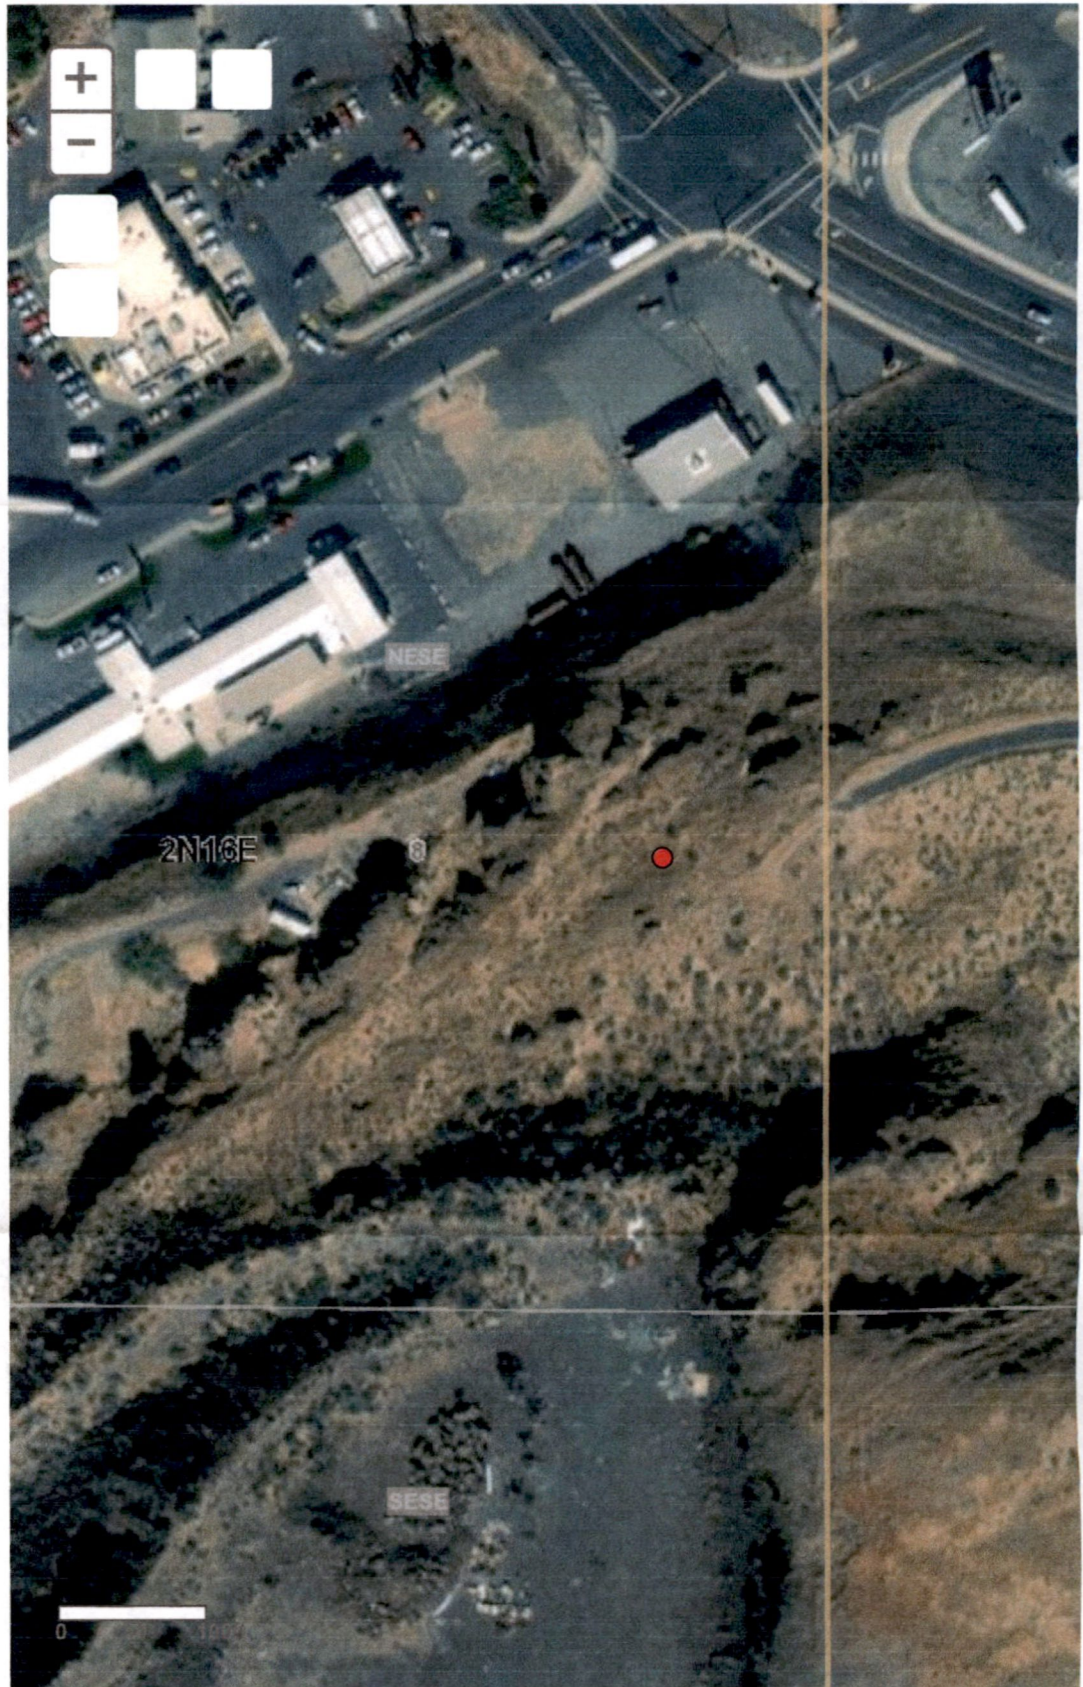

L134784

1N

RECEIVED

MAY 12 2023

OWRD