

TILL
512

OBSERVATION WELL
Well Record


STATE WELL NO. 1/9W-27E (1)
COUNTY Tillamook
APPLICATION NO. GR-250

OWNER: Virgil Chadwick Mailing Address:

LOCATION OF WELL: Owner's No. CITY AND STATE: Tillamook, Oregon

SW 1/4 NW 1/4 Sec. 27 T. 1 S., R. 9 W., W.M.

Bearing and distance from section or subdivision corner 275' E. & 1020' N. of W. 1/4 Cor. Sec. 27

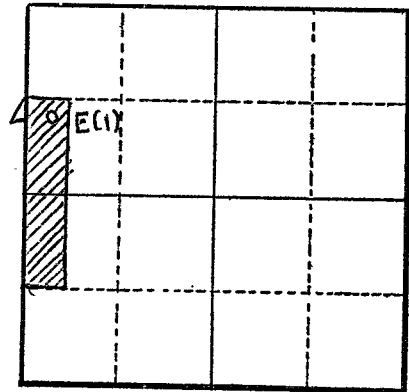

Altitude at well 15 to 18 feet

TYPE OF WELL: Drilled Date Constructed 11-58

Depth drilled 197 Depth cased 197

Section 27

CASING RECORD:

8 inch

FINISH:

AQUIFERS:

WATER LEVEL:

80

PUMPING EQUIPMENT: Type Turbine H.P. 15
Capacity 500 G.P.M.

WELL TESTS:

Drawdown ft. after hours G.P.M.
Drawdown ft. after hours G.P.M.

USE OF WATER Irrigation Temp. °F., 19

SOURCE OF INFORMATION

DRILLER or DIGGER Paul Ross, Hillsboro

ADDITIONAL DATA:

Log X Water Level Measurements Chemical Analysis Aquifer Test

REMARKS:

