

STATE ENGINEER
Salem, Oregon

TLL
513

Well Record


STATE WELL NO. 1/9W-28 L(1)
COUNTY Tillamook
APPLICATION NO. GR - 3343

OWNER: Dave G. Cline MAILING ADDRESS: Rt. 2, Box 356

LOCATION OF WELL: Owner's No. CITY AND STATE: Tillamook, Oregon

NE 1/4 SW 1/4 Sec. 28 T. 1 S. R. 9 W., W.M.

Bearing and distance from section or subdivision corner 1100 ft. south & 700 ft. west from the center of Section 28.

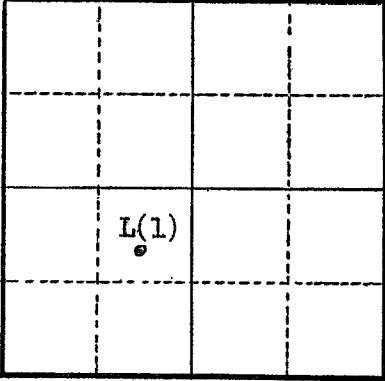

Section 28

Altitude at well

TYPE OF WELL: drilled Date Constructed 1951

Depth drilled 200 Depth cased

CASING RECORD:

8 inch

FINISH:

Perforated

AQUIFERS:

WATER LEVEL:

8 ft. below land surface

PUMPING EQUIPMENT: Type Turbine H.P. 3
Capacity G.P.M.

WELL TESTS:

Drawdown ft. after hours G.P.M.
Drawdown ft. after hours G.P.M.

USE OF WATER Irrigation Temp. °F. 19

SOURCE OF INFORMATION GR - 3096

DRILLER or DIGGER ? ?

ADDITIONAL DATA:

Log ^{na} Water Level Measurements Chemical Analysis Aquifer Test

REMARKS: