

STATE ENGINEER
Salem, Oregon

TILL
529

OBSERVATION WELL
Well Record

STATE WELL NO. 1/9W-31E
COUNTY Tillamook
APPLICATION NO. GR-3353
GR-3104

OWNER: Lester E. Armstrong


MAILING ADDRESS: Rt. 3, Box 18

LOCATION OF WELL: Owner's No.

CITY AND STATE: Tillamook

SW 1/4 NW 1/4 Sec. 31 T. 1 N. S, R. 9 W., W.M.

Bearing and distance from section or subdivision
corner 627' N. & 262' E. from E 1/4 Cor. Sec. 31

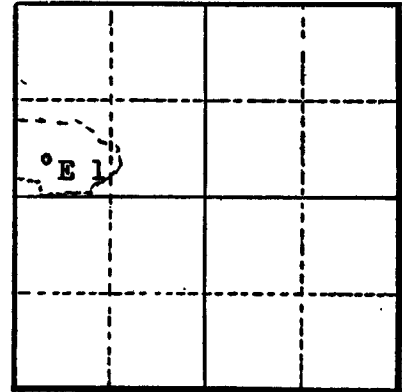

Section 31

Altitude at well

TYPE OF WELL: Drilled Date Constructed 1953

Depth drilled 106 Depth cased 105

CASING RECORD:

8 inch

FINISH:

Perforated

AQUIFERS:

WATER LEVEL:

5 feet below land surface

PUMPING EQUIPMENT: Type Cent. H.P. 5
Capacity 208 G.P.M.

WELL TESTS:

Drawdown 10 ft. after hours Pumping 500 G.P.M.

Drawdown ft. after hours G.P.M.

USE OF WATER Irrigation Temp. °F. 19

SOURCE OF INFORMATION GR-3353

DRILLER or DIGGER Paul Ross

ADDITIONAL DATA:

Log Water Level Measurements Chemical Analysis Aquifer Test

REMARKS:

Log not available.