

STATE ENGINEER
Salem, Oregon

TILL
532


OBSERVATION WELL
Well Record

STATE WELL NO. 1/9N-32R(1)
COUNTY TILLAMOOK
APPLICATION NO. GR-2747

OWNER: Elbert E. Leonnig
MAILING ADDRESS: Rt. 2, Box 394

LOCATION OF WELL: Owner's No.
CITY AND STATE: Tillamook, Oregon

SE 1/4 SW 1/4 Sec. 32 T. 1 S., R. 9 W., W.M.
Bearing and distance from section or subdivision
corner 670' N. and 700' W. from S 1/4 cor. sec. 32

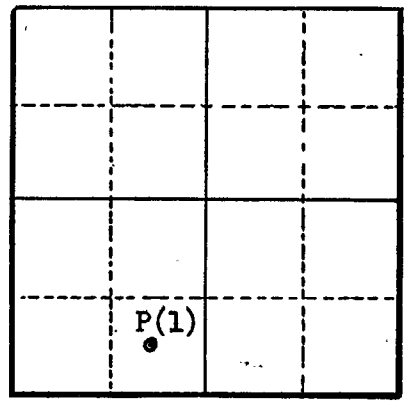

Section 32

Altitude at well

TYPE OF WELL: drilled Date Constructed 1951

Depth drilled 70 Depth cased 70

CASING RECORD:

8-inch

FINISH:

AQUIFERS:

Loam and clay

WATER LEVEL:

12-feet

PUMPING EQUIPMENT: Type Pacific Centrifugal H.P. 7 1/2
Capacity 200 G.P.M.

WELL TESTS:

Drawdown 2 ft. after hours Pumping 200 G.P.M.
Drawdown ft. after hours G.P.M.

USE OF WATER irrigation Temp. °F. 19

SOURCE OF INFORMATION GR-2598

DRILLER or DIGGER Paul Ross, Aloha, Oregon

ADDITIONAL DATA:

Log X Water Level Measurements Chemical Analysis Aquifer Test

REMARKS:

6' Loam
64' clay 70'