

STATE ENGINEER  
Salem, Oregon

TILL  
533

# Well Record

STATE WELL NO. 1/9W-32Q(1)  
COUNTY TILLAMOOK  
APPLICATION NO. GR-2951

OWNER: Cyril A. & Loretta Jacob

MAILING ADDRESS:

Rt. 2, Box 392


LOCATION OF WELL: Owner's No.

CITY AND STATE:

Tillamook, Oregon

SW ¼ SE ¼ Sec. 32 T. 1 S., R. 9 W., W.M.

Bearing and distance from section or subdivision corner 500' N. and 300' E. from S¼ cor. sec. 32

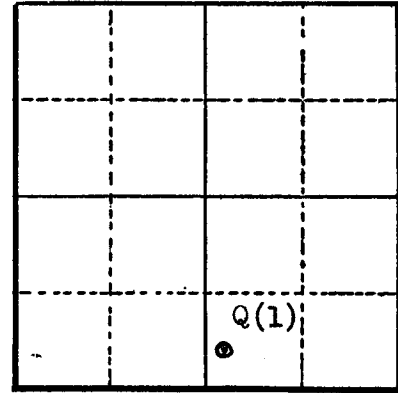

Section 32

Altitude at well

TYPE OF WELL: drilled Date Constructed 1938

Depth drilled 118 Depth cased 118

### CASING RECORD:

8-inch

### FINISH:

### AQUIFERS:

### WATER LEVEL:

10-feet

PUMPING EQUIPMENT: Type Pacific Centrifugal H.P. 7½  
Capacity 200 G.P.M.

### WELL TESTS:

Drawdown 4 ft. after hours Pumping 200 G.P.M.  
Drawdown ft. after hours G.P.M.

USE OF WATER Irrigation Temp. °F., 19

SOURCE OF INFORMATION GR-2770

DRILLER or DIGGER

### ADDITIONAL DATA:

Log NA Water Level Measurements Chemical Analysis Aquifer Test

### REMARKS: