

STATE ENGINEER
Salem, Oregon

TILE
534

Well Record

STATE WELL NO. 1/9W-32J(1)
COUNTY Tillamook
APPLICATION NO. GR- 3008

OWNER: Louis Reding


MAILING ADDRESS: Rt. 1 Box 382

LOCATION OF WELL: Owner's No.

CITY AND STATE: Tillamook, Oregon

NE 1/4 SE 1/4 Sec. 32 T. 1 S, R. 9 W., W.M.

Bearing and distance from section or subdivision corner N.81°57'W. 792' from SE cor. of the James Quick DLC.

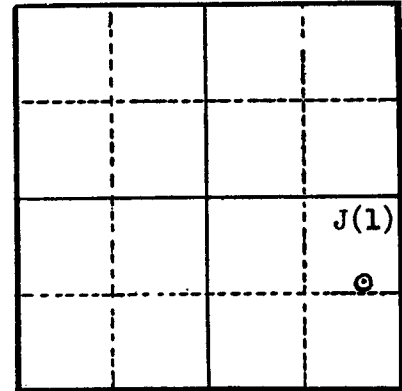

Altitude at well

Section 32

TYPE OF WELL: Drilled Date Constructed 1949

Depth drilled 28' Depth cased

CASING RECORD:

8 inch

FINISH:

Perforated

AQUIFERS:

WATER LEVEL:

0 to 6 feet

PUMPING EQUIPMENT: Type Centrifugal H.P. 7 1/2
Capacity 200 G.P.M.

WELL TESTS:

Drawdown ft. after hours G.P.M.
Drawdown ft. after hours G.P.M.

USE OF WATER Irrigation Temp. °F. 19

SOURCE OF INFORMATION GR- 2817

DRILLER or DIGGER

ADDITIONAL DATA:

Log NA Water Level Measurements Chemical Analysis Aquifer Test

REMARKS: