

STATE ENGINEER
Salem, Oregon

TILL
538

Well Record


STATE WELL NO. 1/9W-33M
COUNTY Tillamook
APPLICATION NO. CR-3323

OWNER: Arthur W. Van Loo
MAILING ADDRESS: Rt. 2, Box 384

LOCATION OF WELL: Owner's No. CITY AND STATE: Tillamook, Oregon

N. E.
NW 1/4 SW 1/4 Sec. 33 T. 1 S., R. 9 W., W.M.

Bearing and distance from section or subdivision
corner 1960 feet North and 320 feet East from
SW corner Sec. 33

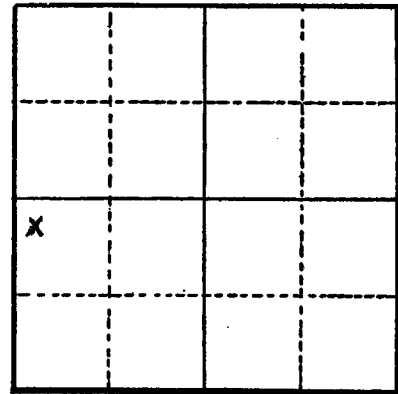

Section 33

Altitude at well

TYPE OF WELL: Drilled Date Constructed 1945

Depth drilled 24 feet Depth cased 24

CASING RECORD:

8 inch casing set to 24 feet

FINISH:

AQUIFERS:

WATER LEVEL:

15 feet below surface

PUMPING EQUIPMENT: Type Jacuzzi H.P. 7 1/2
Capacity 200 G.P.M.

WELL TESTS:

Drawdown 4 ft. after 200 hours G.P.M.

Drawdown ft. after hours G.P.M.

USE OF WATER Irrigation Temp. °F., 19

SOURCE OF INFORMATION Well Registration Statement

DRILLER or DIGGER

ADDITIONAL DATA:

Log Water Level Measurements Chemical Analysis Aquifer Test

REMARKS: