

STATE ENGINEER
Salem, Oregon

TILL
619

Well Record

STATE WELL NO. 1/10W-11A
COUNTY TILLAMOOK
APPLICATION NO. GR-3704

OWNER: Bernice Wilkins

MAILING ADDRESS:

LOCATION OF WELL: Owner's No.


CITY AND STATE:

Bay City, Oregon

NE ¼ NE ¼ Sec. 11 T. 1 S., R. 10 W., W.M.

Bearing and distance from section or subdivision

corner 650' S & 1100' W from NE cor Sec 11

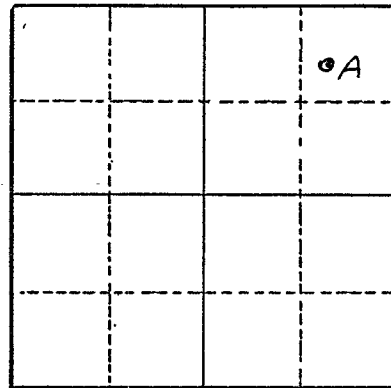

Section 11

Altitude at well

TYPE OF WELL: Drilled Date Constructed 1953

Depth drilled 42' Depth cased 42'

CASING RECORD:

6-inch

FINISH:

AQUIFERS:

WATER LEVEL:

15'

PUMPING EQUIPMENT: Type Jacuzzi

H.P. 1½

Capacity 50 G.P.M.

WELL TESTS:

Drawdown 20 ft. after hours 500 G.P.M.

Drawdown ft. after hours G.P.M.

USE OF WATER Irrigation Temp. °F., 19

SOURCE OF INFORMATION GR-3951

DRILLER or DIGGER Oregon State Highway Dept.

ADDITIONAL DATA:

Log NA Water Level Measurements Chemical Analysis Aquifer Test

REMARKS: