

STATE ENGINEER
Salem, Oregon

TILL
620

Well Record

STATE WELL NO. 1/10W-3K¹²
COUNTY Tillamook
APPLICATION NO. GR-3918

OWNER: Anna Neilson Toland

MAILING

ADDRESS: Route 1


LOCATION OF WELL: Owner's No. _____

CITY AND

STATE: Bay City, Oregon

NW ¹² 1/4 SE 1/4 Sec. ~~3~~ T. 1 S., R. 10 W., W.M.

Bearing and distance from section or subdivision
corner 850' S. & 530' W. of NW Cor. of NE 1/4 SE 1/4

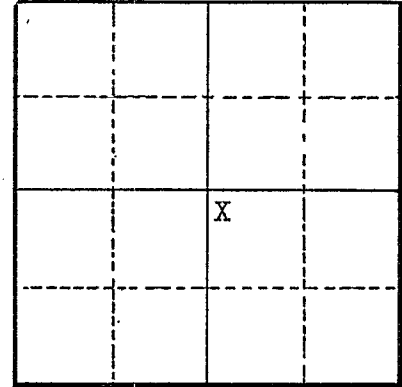

Section ~~11~~ 12

Altitude at well _____

TYPE OF WELL: Drilled Date Constructed 3/10/52

Depth drilled 65 ft. Depth cased 65 ft.

CASING RECORD:

8 inch steel pipe from 0 to 65 feet

FINISH:

1/4" x 2 1/2" - 135 perforations from 40 to 65 feet

AQUIFERS:

WATER LEVEL:

7 1/2 feet below surface

PUMPING EQUIPMENT: Type Wyss-Cornell

H.P. 5

Capacity 300 G.P.M.

WELL TESTS:

Drawdown 1/2 ft. after _____ hours 84 G.P.M.

Drawdown 1 ft. after _____ hours 300 G.P.M.

USE OF WATER Irrigation Temp. _____ °F., 19

SOURCE OF INFORMATION Well Registration Statement Cert. # GR-3555

DRILLER or DIGGER Paul Ross

ADDITIONAL DATA:

Log Water Level Measurements _____ Chemical Analysis _____ Aquifer Test _____

REMARKS:

Log:

River bottom soil
Blue tideland clay
Water bearing gravel

Thickness	Depth to Bottom
0	8
8	50
50	65