

STATE ENGINEER
Salem, Oregon

TILL
621

OBSERVATION WELL
Well Record

STATE WELL NO. 1/10W-12D
COUNTY Tillamook
APPLICATION NO. GR-3357

OWNER: Leo and Robert Wassmer


MAILING ADDRESS: Route 1, Box 94

LOCATION OF WELL: Owner's No.

CITY AND STATE: Bay City, Oregon

NW 1/4 NW 1/4 Sec. 12 T. 1 S., R. 10 W., W.M.

Bearing and distance from section or subdivision corner 1200' E and 330' S. from the N.W. Corner of Section 12

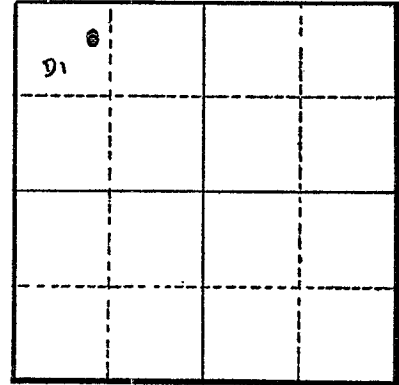

Section 12

Altitude at well

TYPE OF WELL: drilled Date Constructed 1952

Depth drilled 80' Depth cased

CASING RECORD:

8"

FINISH:

AQUIFERS:

WATER LEVEL:

12'

PUMPING EQUIPMENT: Type H.P. 5
Capacity 125 G.P.M.

WELL TESTS:

Drawdown 12 ft. after hours pumping 125 G.P.M.

Drawdown ft. after hours G.P.M.

USE OF WATER Irrigation Temp. °F. 19

SOURCE OF INFORMATION GR-3108

DRILLER or DIGGER Paul Ross Alaho, Oregon

ADDITIONAL DATA:

Log Water Level Measurements Chemical Analysis Aquifer Test

REMARKS: