

STATE ENGINEER  
Salem, Oregon

TILL  
627

# Well Record

STATE WELL NO. 1/10W-24M(1)  
COUNTY TILLAMOOK  
~~REGISTRATION NO.~~ GR-2952  
Certificate No.

OWNER: Antone & Johanna Beeler


MAILING ADDRESS: Rt. 1

LOCATION OF WELL: Owner's No.

CITY AND STATE: Bay City, Oregon

NW ¼ SW ¼ Sec. 24 T. 1 N. S. R. 10 E. W. W.M.

Bearing and distance from section or subdivision corner 650' S. and 310' E. from the NW corner of the SW ¼ of section 24

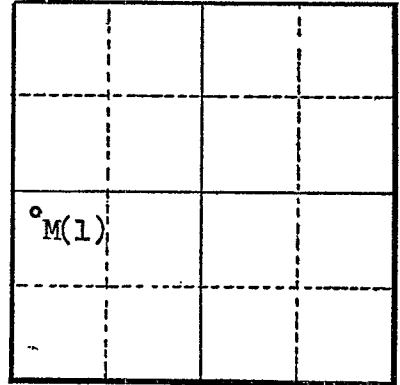

Section 24

Altitude at well

TYPE OF WELL: drilled Date Constructed 1951

Depth drilled 115 Depth cased 115

### CASING RECORD:

9-inch

### FINISH:

About ¼" perforations from 0 to 38

### AQUIFERS:

Clay

### WATER LEVEL:

8-feet

PUMPING EQUIPMENT: Type Electric H.P. 5  
Capacity 200 G.P.M.

### WELL TESTS:

Drawdown 9 ft. after hours Pumping 184 G.P.M.

Drawdown ft. after hours G.P.M.

USE OF WATER Irrigation GR-2771 Temp. °F. 19

### SOURCE OF INFORMATION

DRILLER or DIGGER

### ADDITIONAL DATA:

Log X Water Level Measurements Chemical Analysis Aquifer Test

### REMARKS:

Blue clay

115