

STATE ENGINEER
Salem, Oregon

TILL
630

Well Record

STATE WELL NO. 1/10W-25E(1)
COUNTY Tillamook
APPLICATION NO. GR-3593

OWNER: Alfred H. Marolf


MAILING ADDRESS: Star Rt. West, Box 13

LOCATION OF WELL: Owner's No.

CITY AND STATE: Tillamook, Oregon

SW 1/4 NW 1/4 Sec. 25 T. 1 S., R. 10 W., W.M.

Bearing and distance from section or subdivision corner 490' E. & 240' S. of SW Cor. of NW 1/4 NW 1/4, Section 25

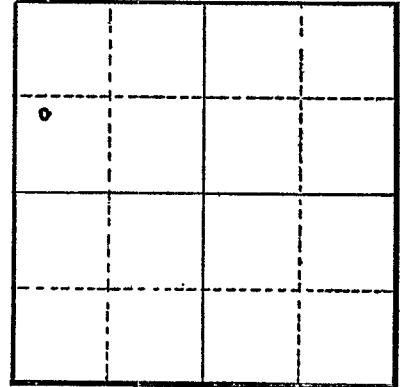

Section 25

Altitude at well

TYPE OF WELL: Drilled Date Constructed Oct., 1954

Depth drilled 75' Depth cased 75'

CASING RECORD:

8 inch casing set to 75 feet

FINISH:

Perforated from 38 feet to 75 feet

AQUIFERS:

Sediments

WATER LEVEL:

3 feet below surface

PUMPING EQUIPMENT: Type Wyss pump centrifugal H.P. 75
Capacity 208 G.P.M.

WELL TESTS:

Drawdown 15 ft. after 500 hours G.P.M.
Drawdown ft. after hours G.P.M.

USE OF WATER Irrigation Temp. °F., 19

SOURCE OF INFORMATION Well Registration Statement

DRILLER or DIGGER

ADDITIONAL DATA:

Log X Water Level Measurements Chemical Analysis Aquifer Test

REMARKS:

